


T. 9 S. R. 3 E. W.M.

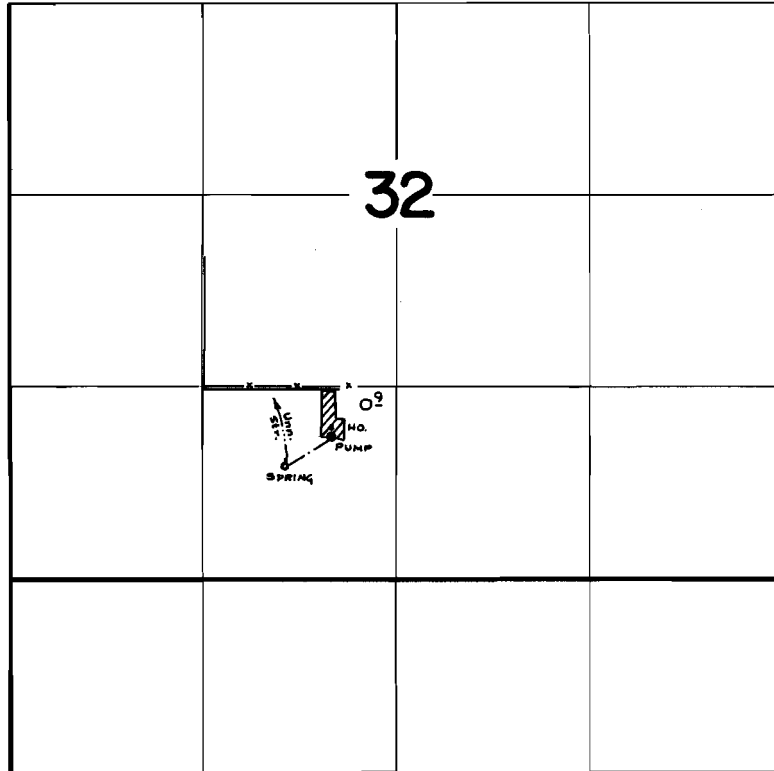

DIV. PT. LOCATED: 550' S & 560' E FROM NW COR. SE $\frac{1}{4}$ SW $\frac{1}{4}$

FINAL PROOF SURVEY UNDER

Application No. 43964 Permit No. 32844
IN NAME OF

WM. E. BEYER

Surveyed Sept. 6, 1972, by D. Norby