


T.9&10S.R.2W.W.M.

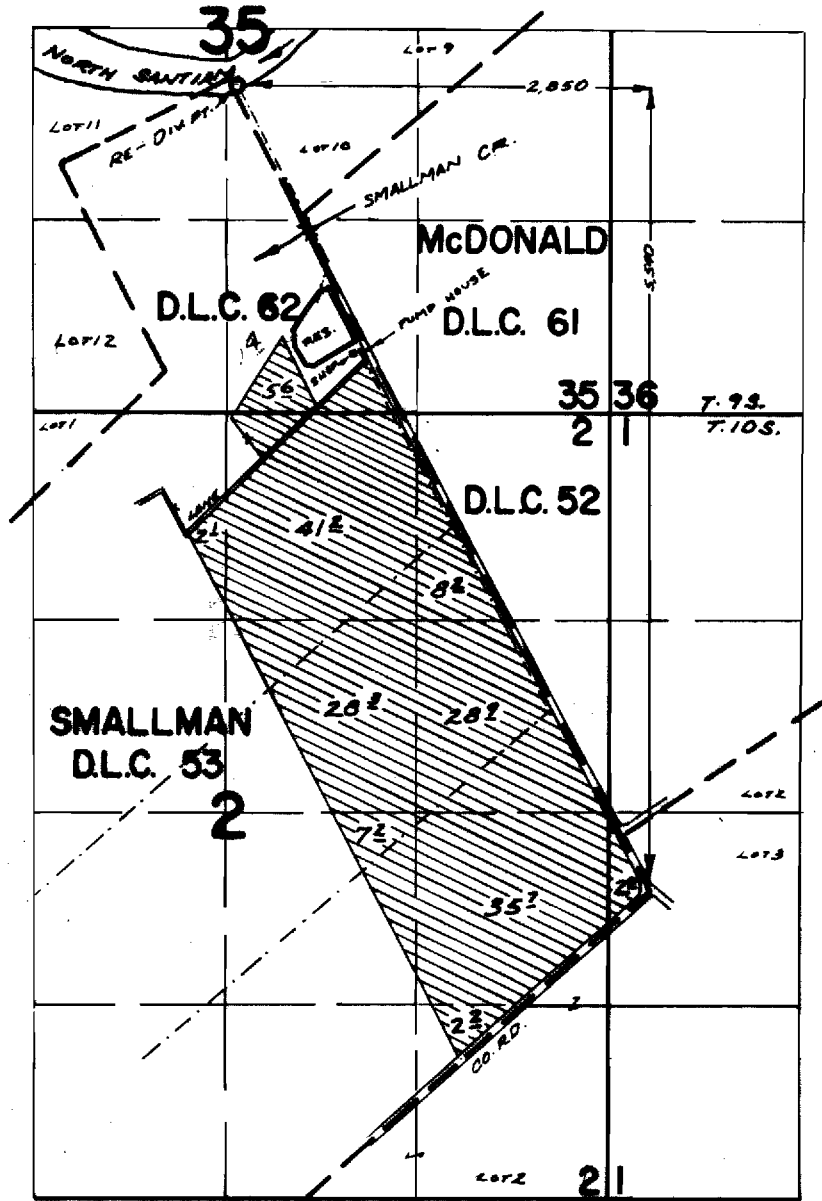

FINAL PROOF SURVEY UNDER

Application No. 45061... Permit No. 33674.
IN NAME OF

WALTER D. & PATRICIA R. MILLER

Surveyed APR. 8, 1970, by R. MUCKEN