


T.9 & 10S.R.2W.W.M.

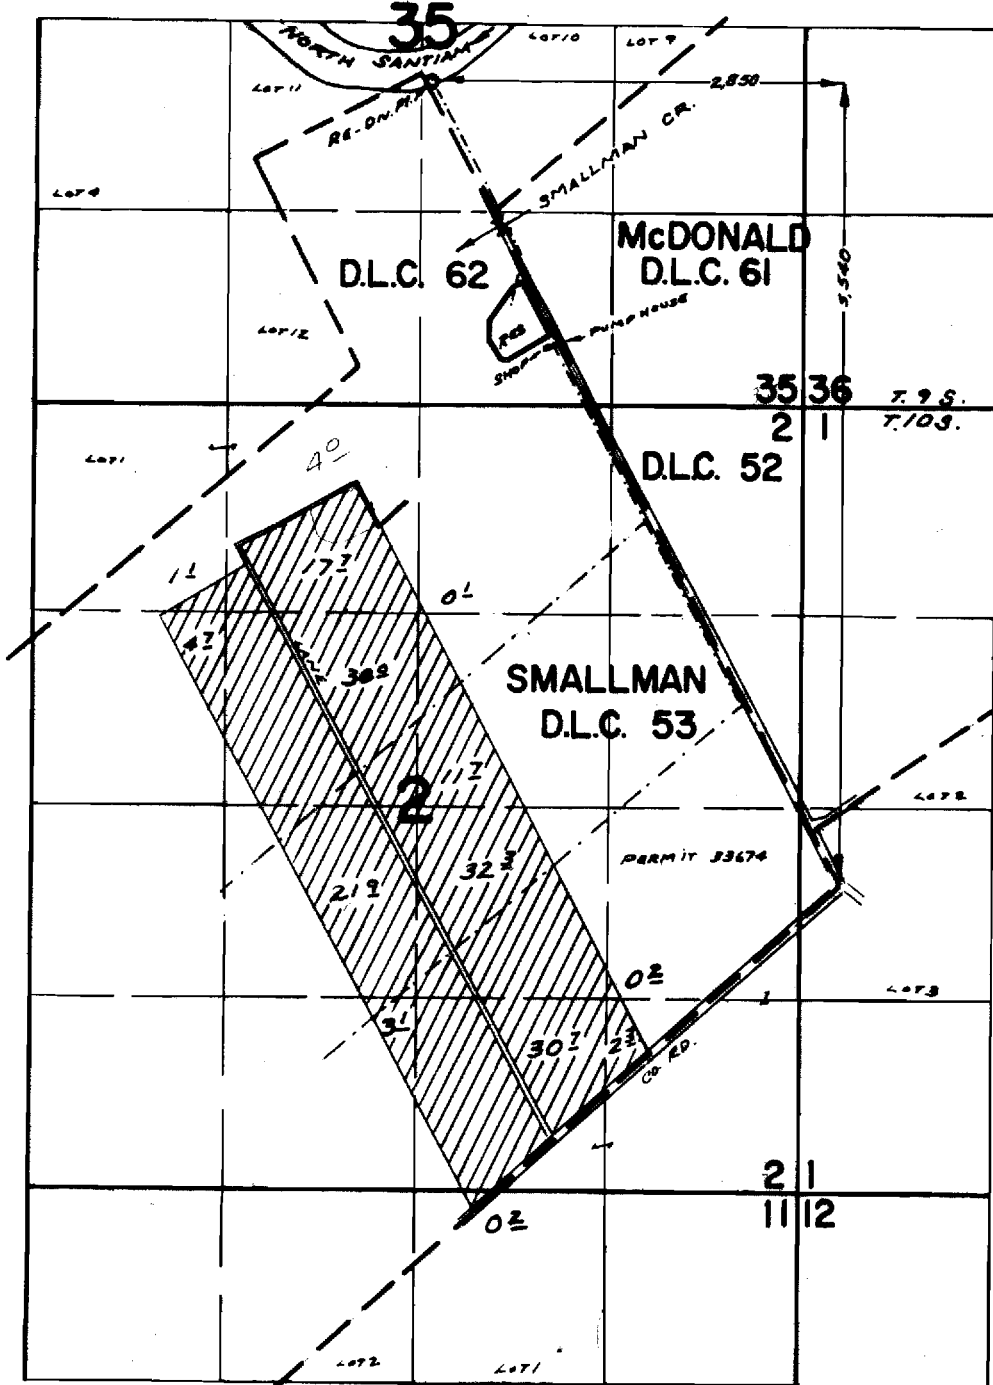

FINAL PROOF SURVEY UNDER

Application No. 45062 Permit No. 33675
IN NAME OF

JOHN D. MILLER

Surveyed APR. 8, 1970, by R. MICKEN.