


T.6S. R.2W. W.M.

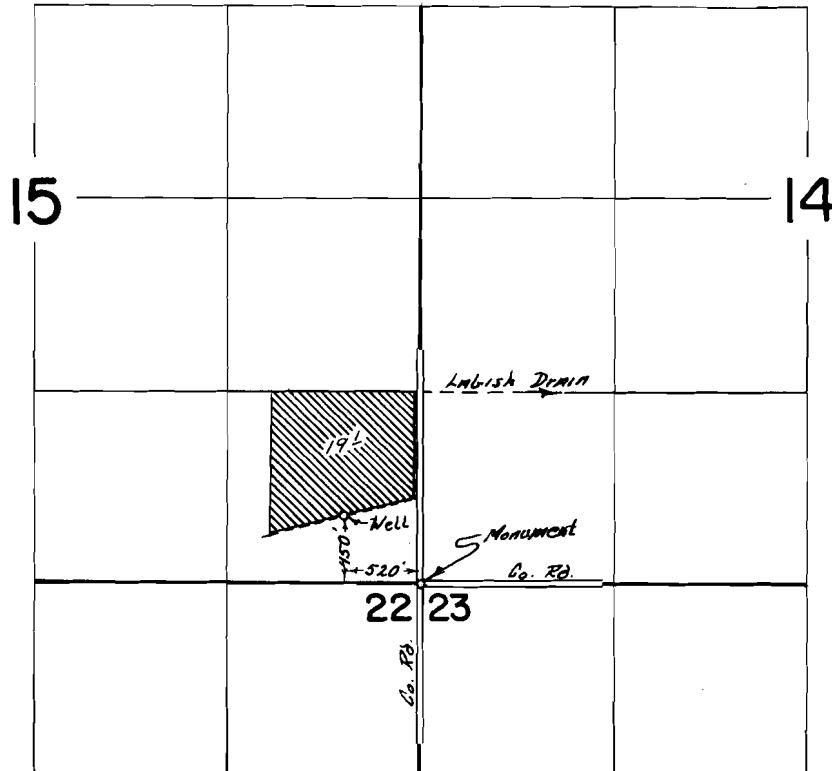

**FINAL PROOF SURVEY**  
UNDER

Application No. B-4441 Permit No. B-4127  
IN NAME OF

JENNIE M. COLLARD

Surveyed May 17 1972, by R. B. Mucken