


T.6S. R.3W. W.M.

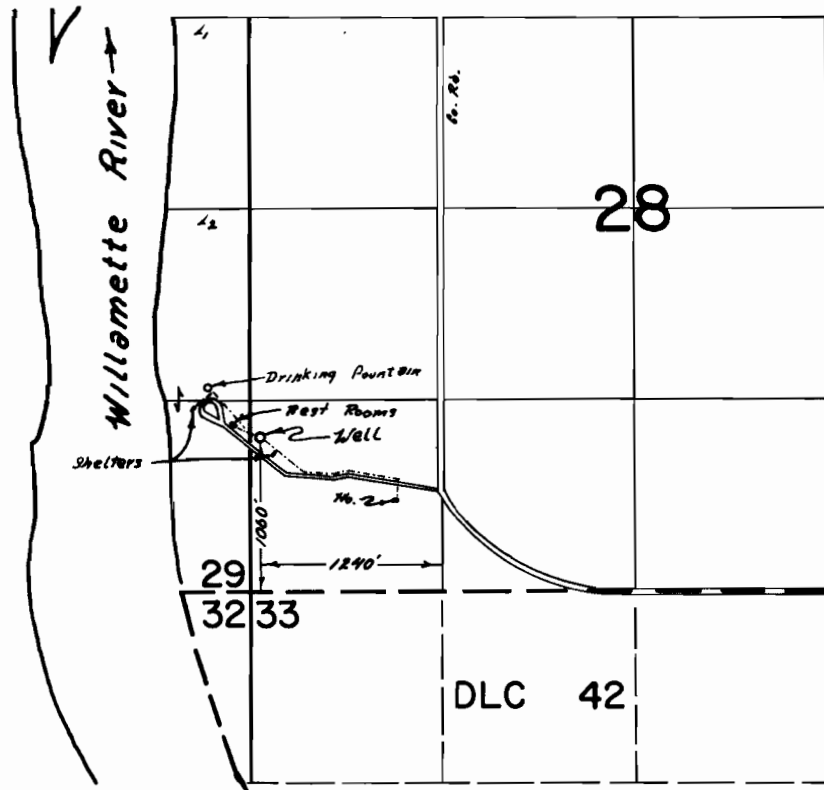

FINAL PROOF SURVEY
UNDER

Application No. G-4802 Permit No. G-4527
IN NAME OF

REGIONAL PARK & RECREATION AGENCY

Surveyed at 29 19 73, by R. G. Mucken