


# T4S R.2W W.M.

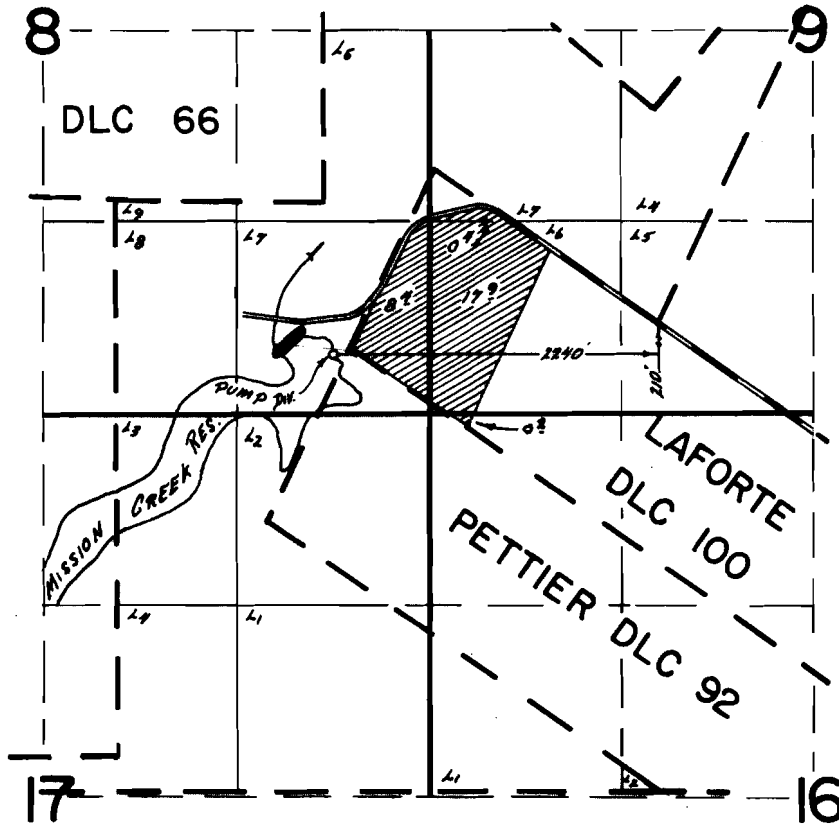

## FINAL PROOF SURVEY UNDER

Application No. 44516 Permit No. 39220  
IN NAME OF

*MISSION CREEK DAM & RESERVOIR Co.*

Surveyed JUNE 8 1973, by R. G. MUCKEN