


T.4S.,R.38E.,W.M.

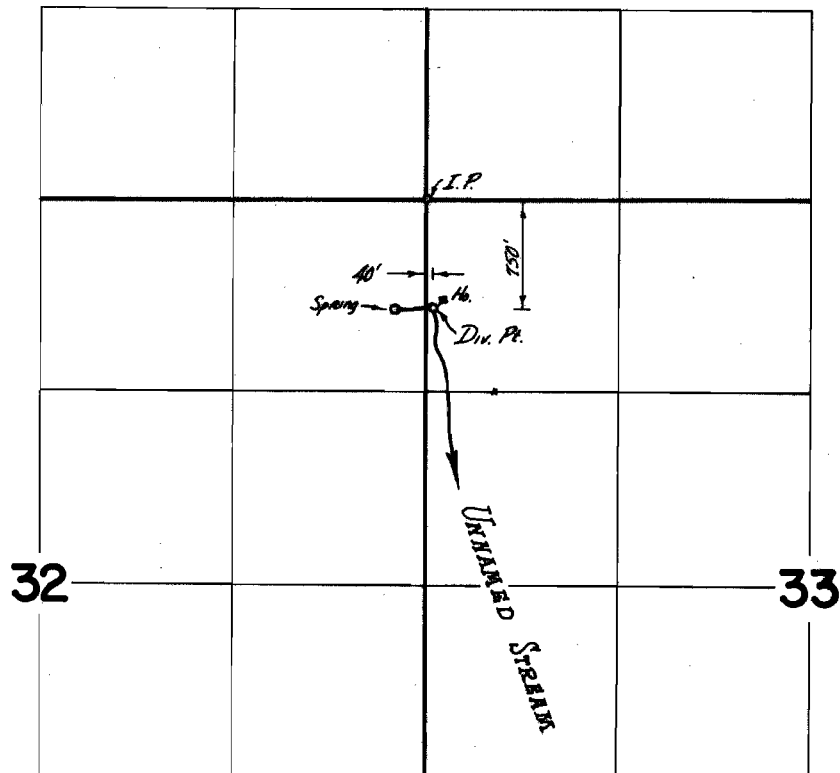

FINAL PROOF SURVEY
UNDER

Application No. 47555 Permit No. 35496
IN NAME OF

GAIL R. VINCENT

Surveyed July 18 1973, by D. NORBY