


T.1S. R.45E. W.M.

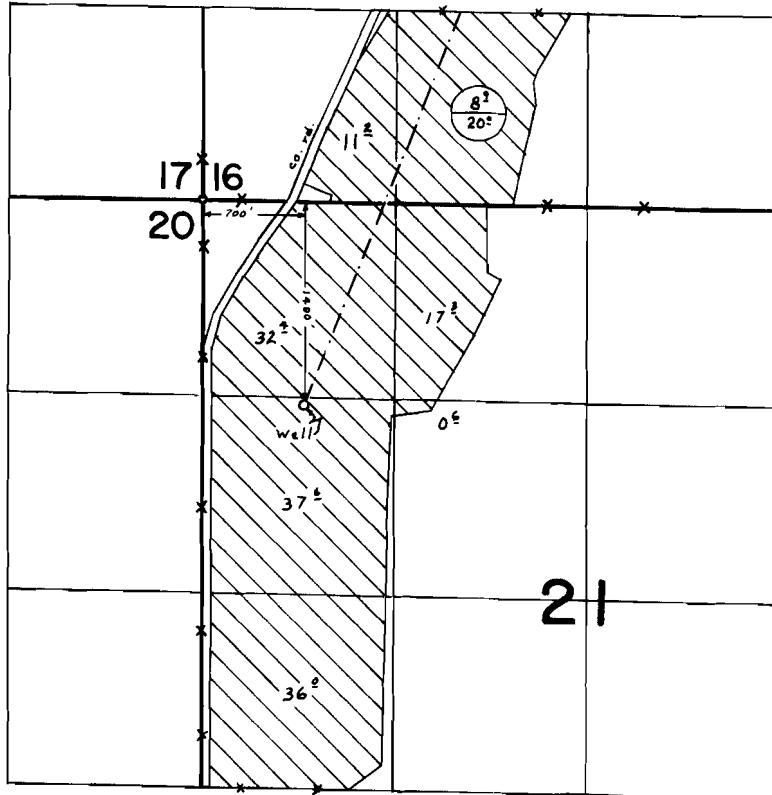

FINAL PROOF SURVEY
UNDER

Application No. G-4239 Permit No. G-4001
IN NAME OF

Gregory J. Wieck

Surveyed AUG. 2, 1973, by K. MUCKEN