


T.1S.R.2W.W.M.

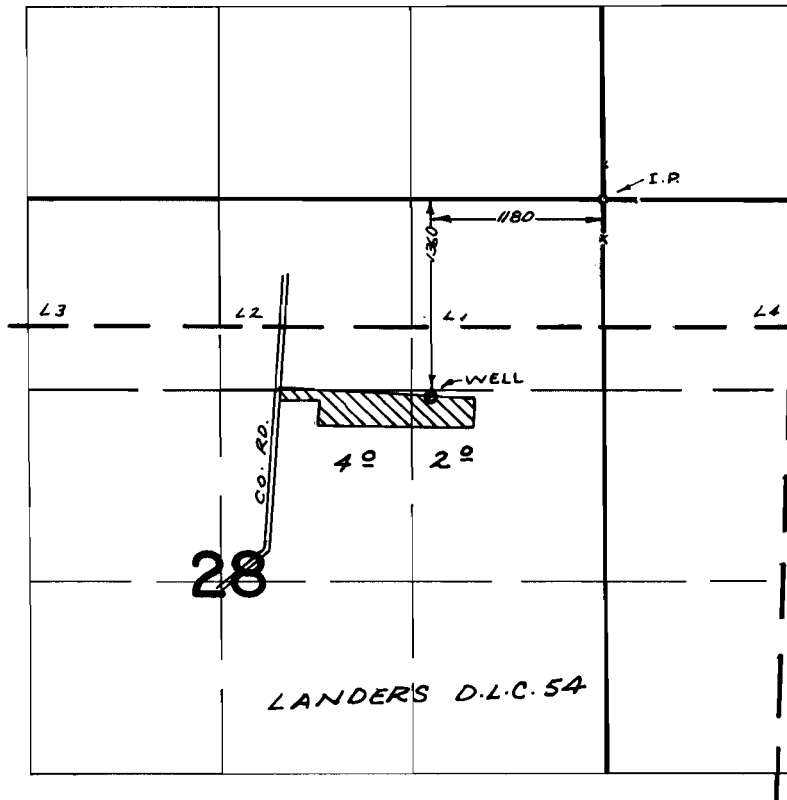

FINAL PROOF SURVEY UNDER

Application No. G-4100 Permit No. G-3848
IN NAME OF

CLIFFORD E. HAWKINSON

Surveyed Nov. 3, 1972, by R. MUCKEN