


T.1N.R.4W. W.M.

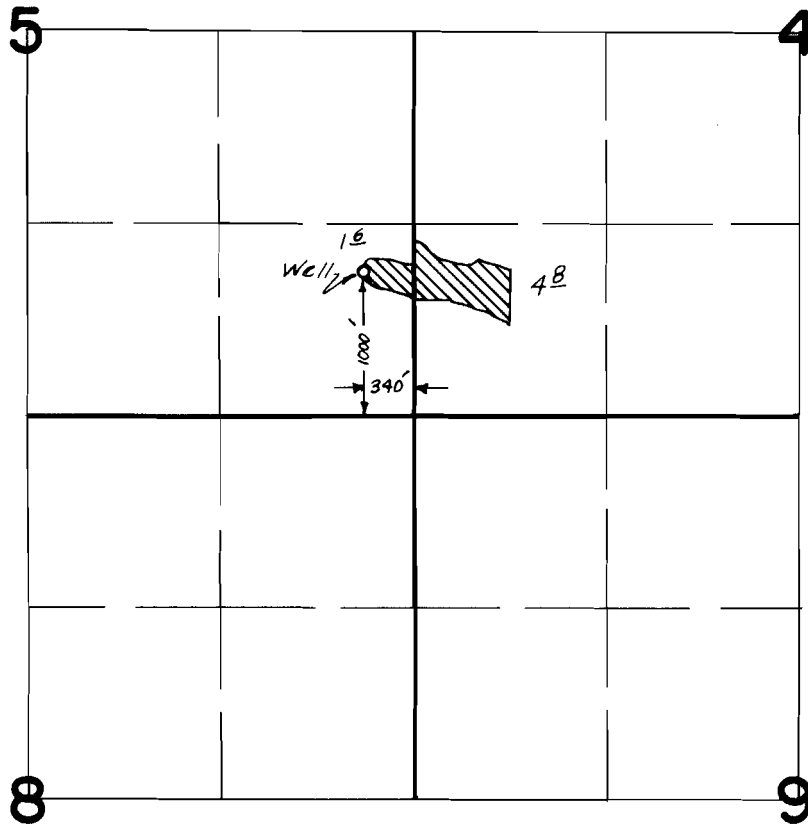

FINAL PROOF SURVEY UNDER

Application No. G-4247 Permit No. G-4007
IN NAME OF

RAY J. & BERTHA A. CONE

Surveyed JUNE 7, 1972, by L. GOULD