


T.I.S.R.I.W.W.M.

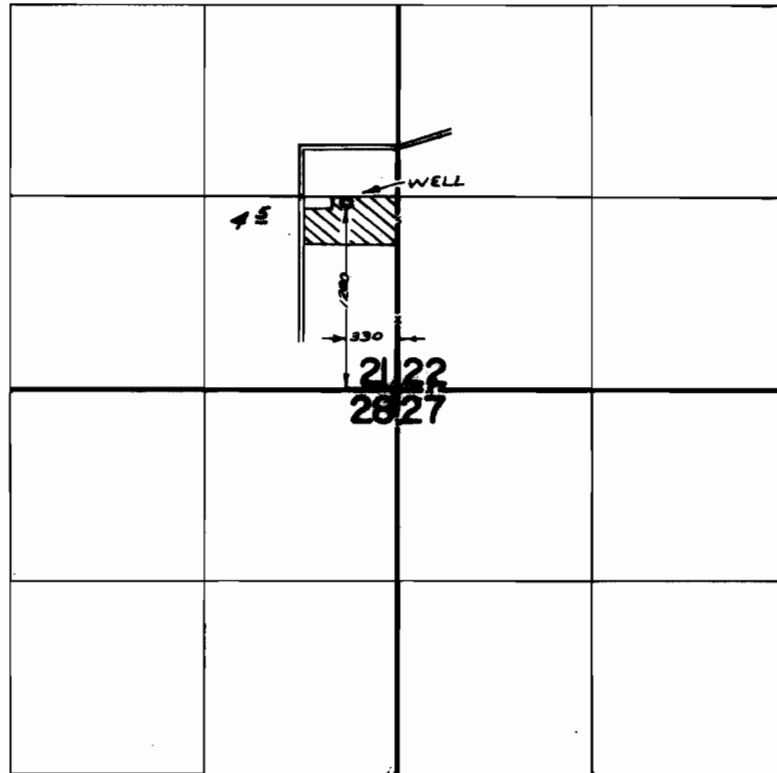

FINAL PROOF SURVEY UNDER

Application No. G-4377 Permit No. G-4131
IN NAME OF

JOHN KLOTZ & ANNA KLOTZ

Surveyed Nov. 1, 1972, by R. MUCKEN