


T.1&2 S., R.1 W., W.M.

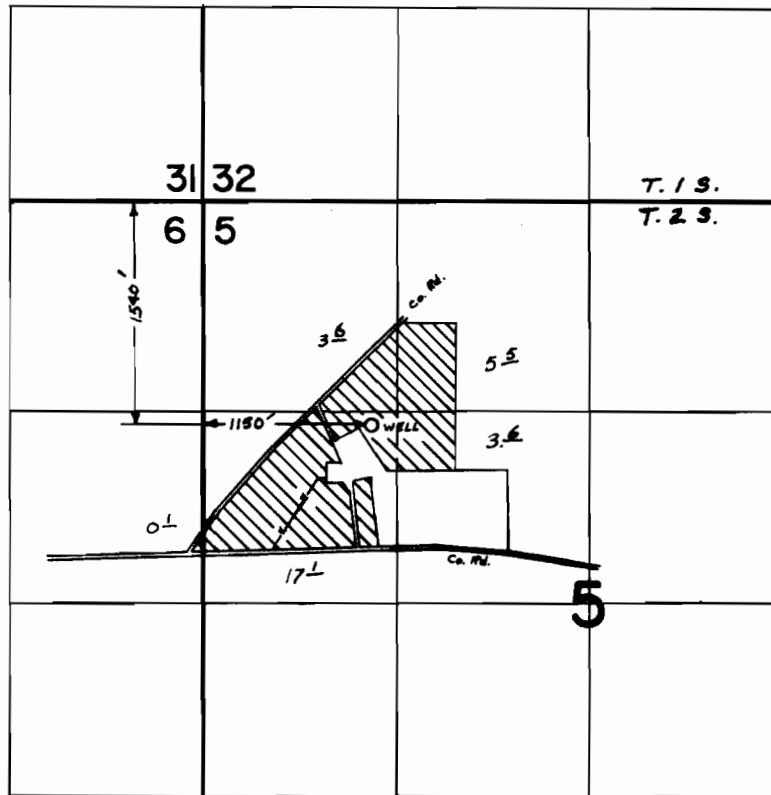

FINAL PROOF SURVEY UNDER

Application No. G-4422 Permit No. G-4167
IN NAME OF

HARRY WERNER

Surveyed OCT 3 1972, by L. GOULD