



# T. 2 S. R. 1 W. W. M.

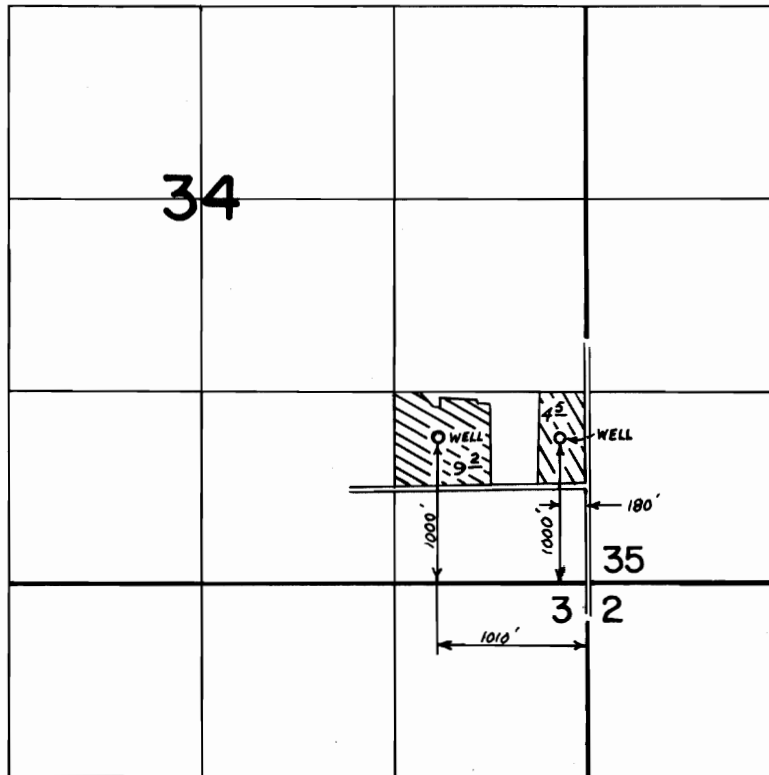

PER. G-2654 

PER. G-4688 

## FINAL PROOF SURVEY UNDER

G-4970                      G-4688  
Application No. G-2851    Permit No. G-2654  
IN NAME OF

LEE H. & MARION B. THOMPSON

Surveyed MAY 16 1973, by R. G. MUCKEN