


# T.1N.R.4W. W.M.

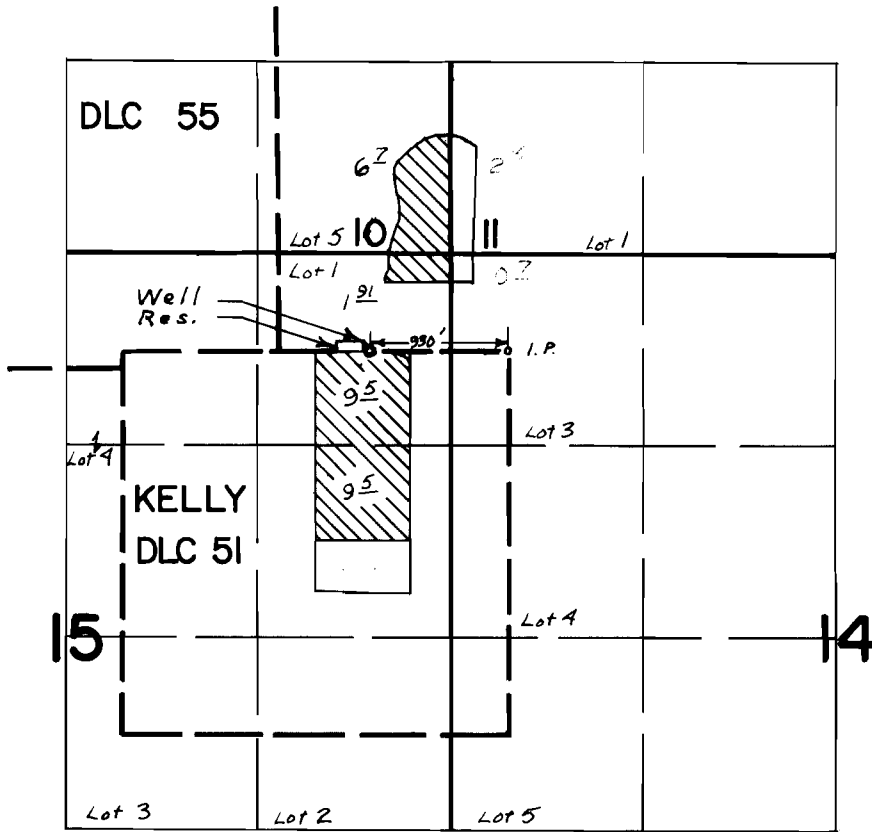

## FINAL PROOF SURVEY UNDER

Application No. G-5126 Permit No. G-4779

IN NAME OF

LEONARD EBERHART

Surveyed JUNE 7 1972, by L. GOULD