


T.2N.R.3W.W.M.

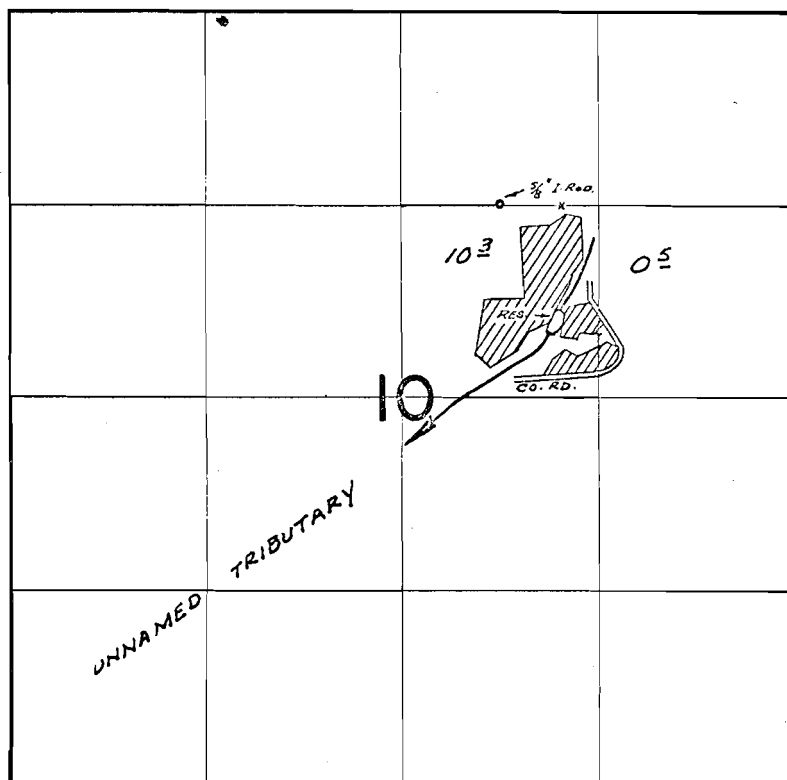

DIV. PT. LOC: 880'S. & 330'E. FROM NW COR. NE 1/4 SW 1/4 NE 1/4 SEC. 10

FINAL PROOF SURVEY UNDER

Application No. 41182 42613 Permit No. 30696 31220
IN NAME OF

V. J. BELT

Surveyed SEPT. 27, 1922, by R. MUCKEN