



# T.1S., R.3W., W.M.

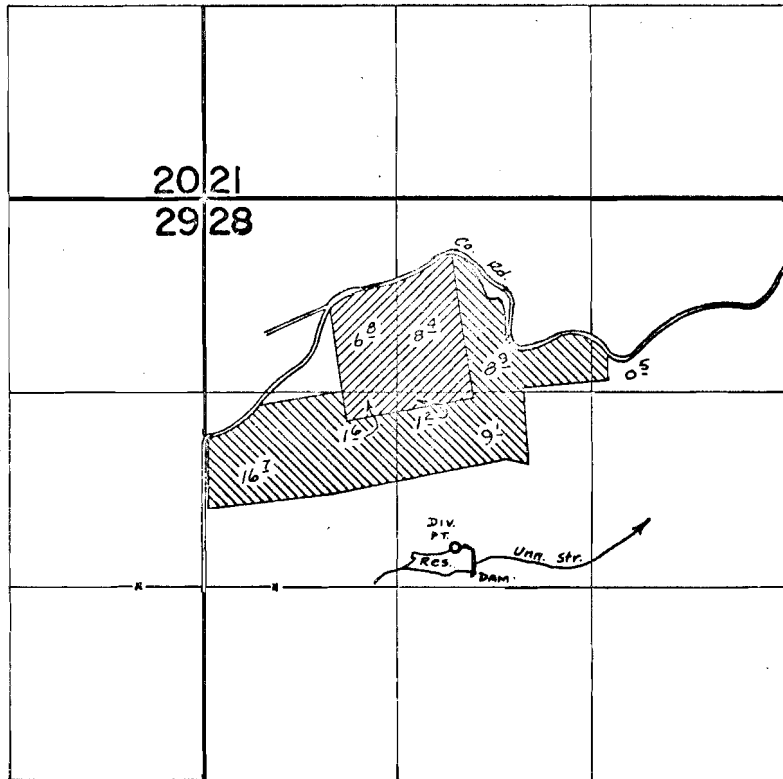

DIV. PTS. LOCATED: STREAM-270' N & 1720' E FROM W $\frac{1}{4}$  COR. SEC. 28.  
RESERVOIR-160' N & 1840' E FROM W $\frac{1}{4}$  COR. SEC. 28.

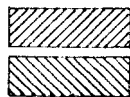

C-162

41051 & 44596

## FINAL PROOF SURVEY

UNDER

Transfer No.

C-162

R-41050

41051

R-44396

44596

R-4735

31261

R-5144

33191

Application No.

Permit No.

IN NAME OF

ROY D. COOK

Surveyed June 15 1972, by D. Norby