


T.3N.R.3W.W.M.

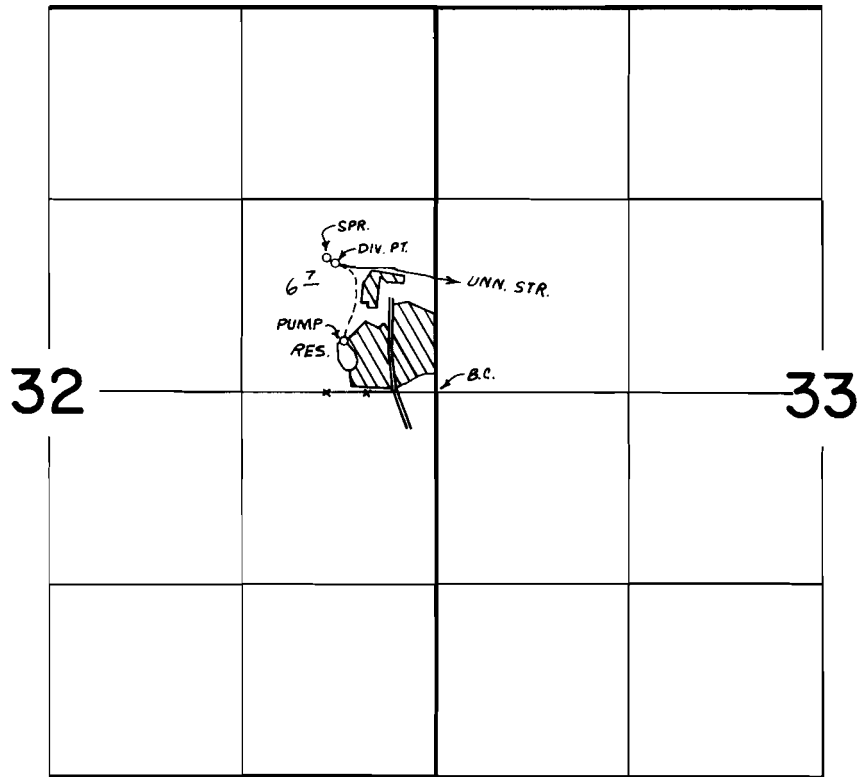

DIV. PT. 890' N & 690' W, PUMP 350' N & 630' W FROM E 1/4 COR SEC 32

FINAL PROOF SURVEY
UNDER

Application No. 43335 Permit No. 32391
R-43334 R-4971
IN NAME OF

JOHN H. DIETRICH

Surveyed JUN 29 1973, by R.G. MUCKEN