


T. 3 N. R. 3 W. W.M.

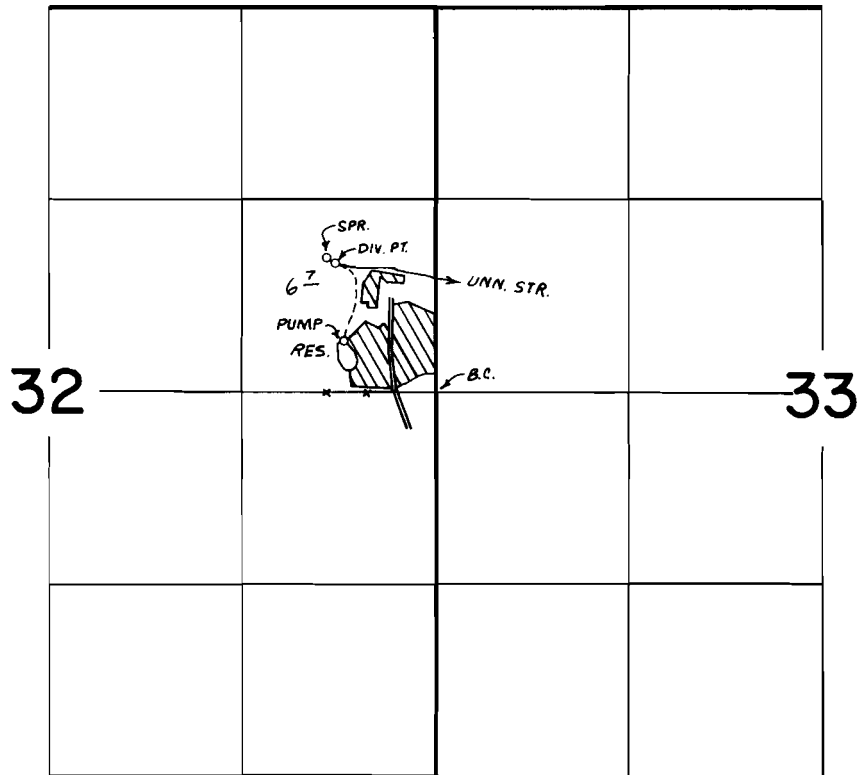

DIV. PT. 890' N & 690' W, PUMP 350' N & 630' W FROM E 1/4 COR SEC 32

FINAL PROOF SURVEY
UNDER

43335 32391
Application No. R-43334 Permit No. R-4971
IN NAME OF

JOHN H. DIETRICH

Surveyed JUN 29 1973, by R.G. MUCKEN