


T. 2 S. R. 1 W. W. M.

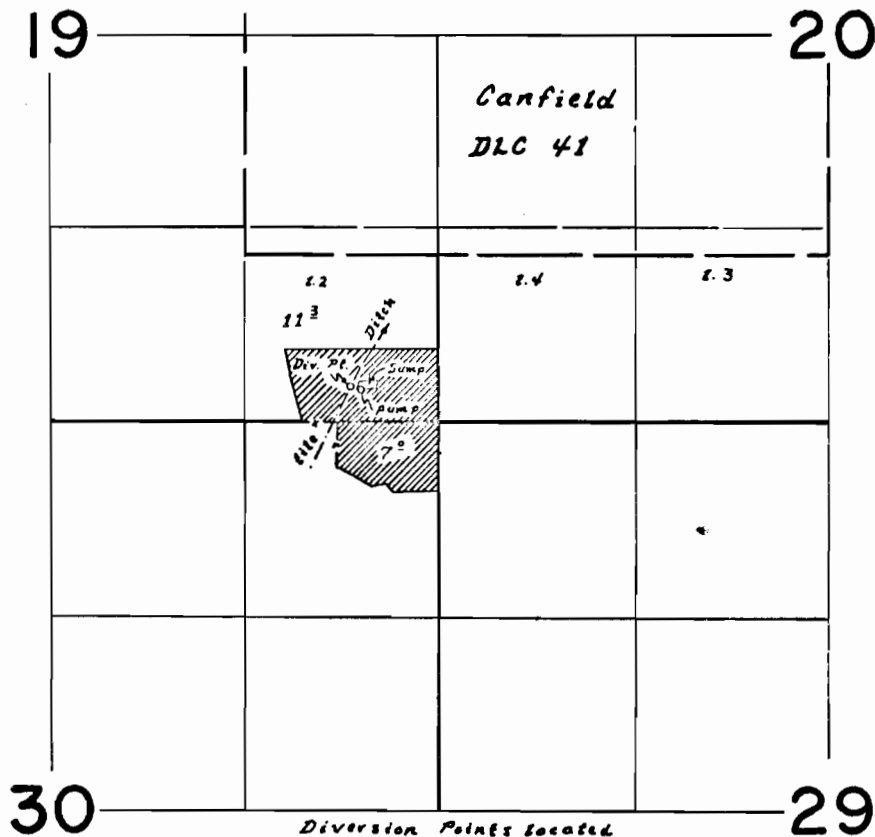

Ditch 240' N. of 590' W. } All sec. from S.E. cor. Sec. 19
Sump 220' N. of 530' W. }

FINAL PROOF SURVEY
UNDER

R-43747

R-5025

Application No. 43748 Permit No. 32692

IN NAME OF

Arnold Conzelman

Surveyed 5 Oct. 1972, by I.E. Gould