


T. 1 N. R. 3 W. W.M.

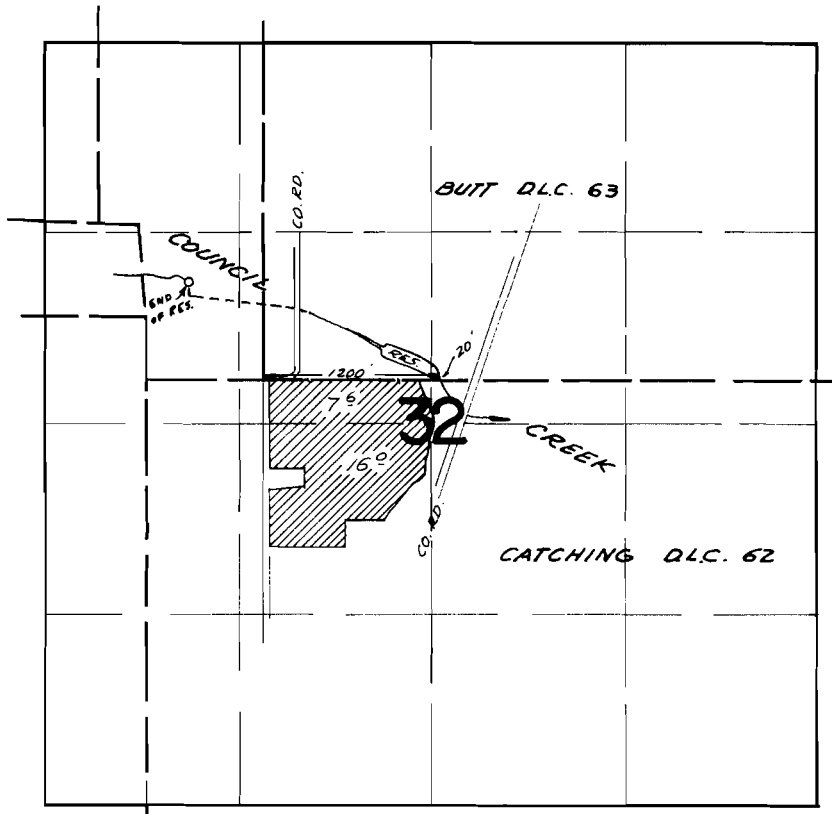

FINAL PROOF SURVEY UNDER

R-46762 R-5591
46763 34921
R-41687 R-4932
Application No. 41734 Permit No. 32256
IN NAME OF

HERBERT B. SAHNOW

Surveyed *June 26 1968*, by *V. Garner*...
JUNE 28 1973 *R.G. MUCKEN*