


T.I.S.R.I.W.W.M.

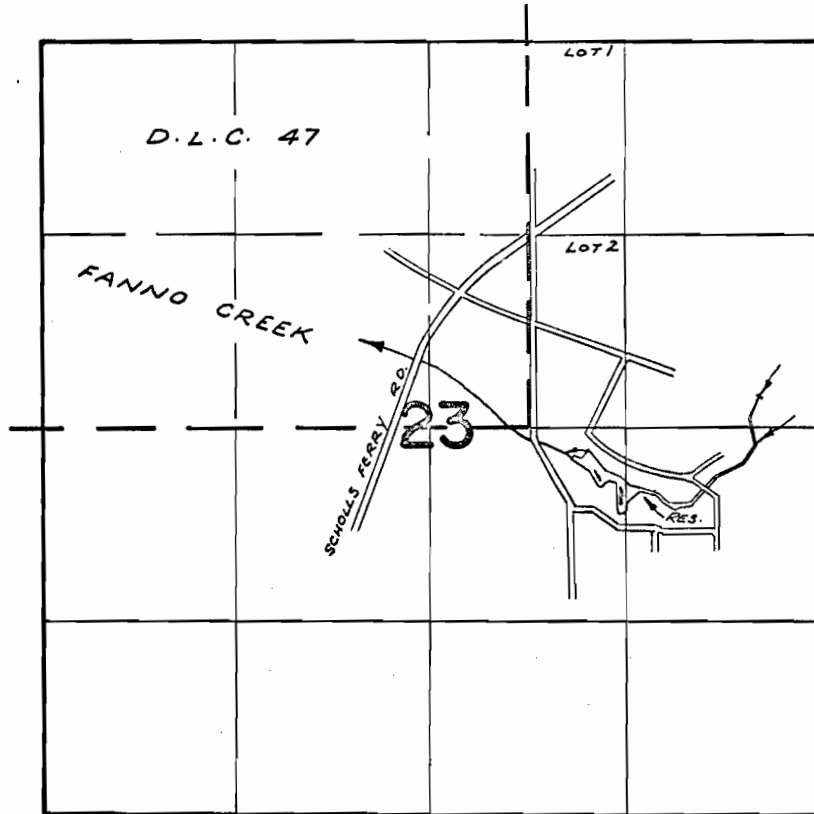

DIV. PT. 200' 200' S. & 1680' W. FROM E 1/4 COR. SEC. 23

FINAL PROOF SURVEY UNDER

Application No. R-46953 46954 Permit No. R-5628 35114
IN NAME OF

FANNO CREEK HOMEOWNERS ASSOC.

Surveyed Nov. 1, 1972, by R. MURKIN