


T. 2 S. R. 1 W. W. M.

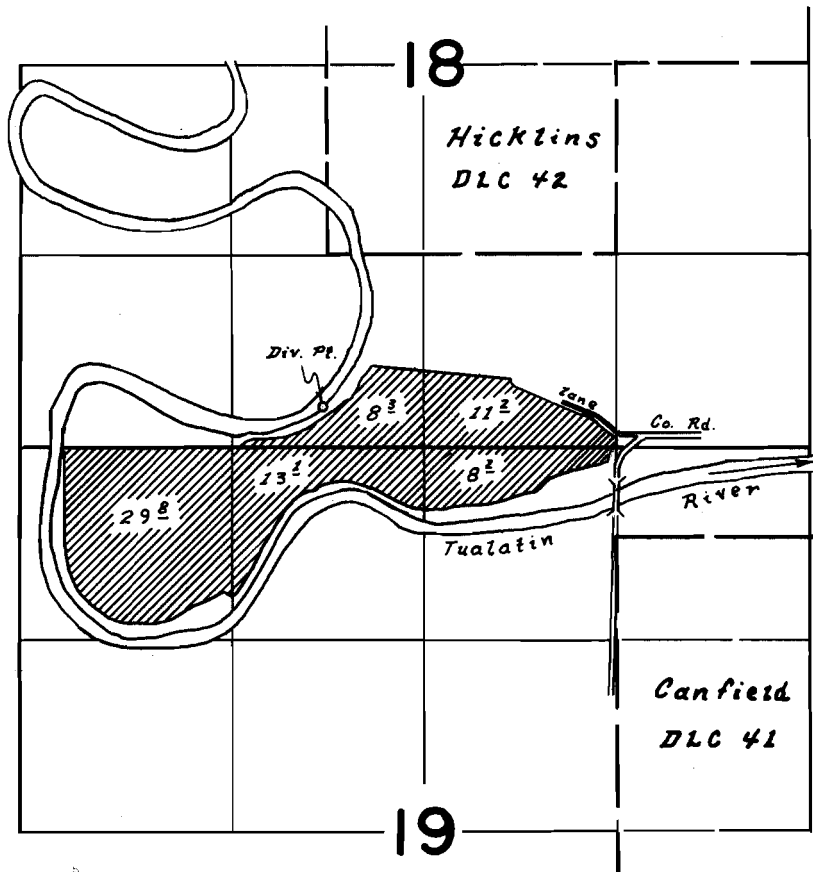

Div. Pt. Loc. 1060' S. & 2030' W. from Sty. S.E. Cor. Hicklins DLC 42

FINAL PROOF SURVEY
UNDER

Application No. 40957 Permit No. 30545
IN NAME OF

Walter H. Gunnell

Surveyed 4 Oct. 1972, by L.E. Gould