


T.1N.R.4W. W.M.

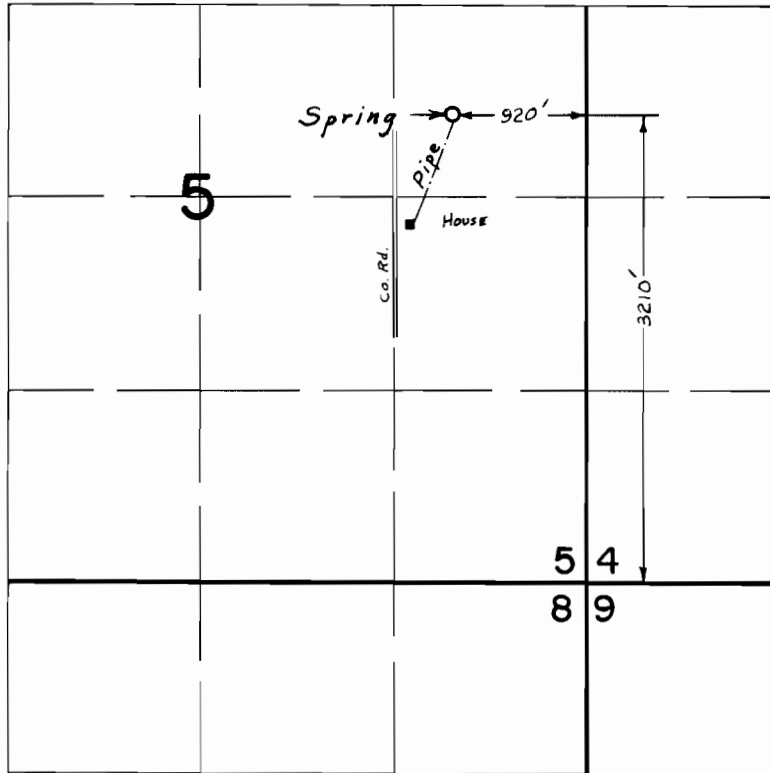

FINAL PROOF SURVEY UNDER

Application No. 43245 Permit No. 32245
IN NAME OF

DWAYNE HEIKES

Surveyed JUNE 6 1972, by L. GOULD