


T.I.S.R.I.W.W.M.

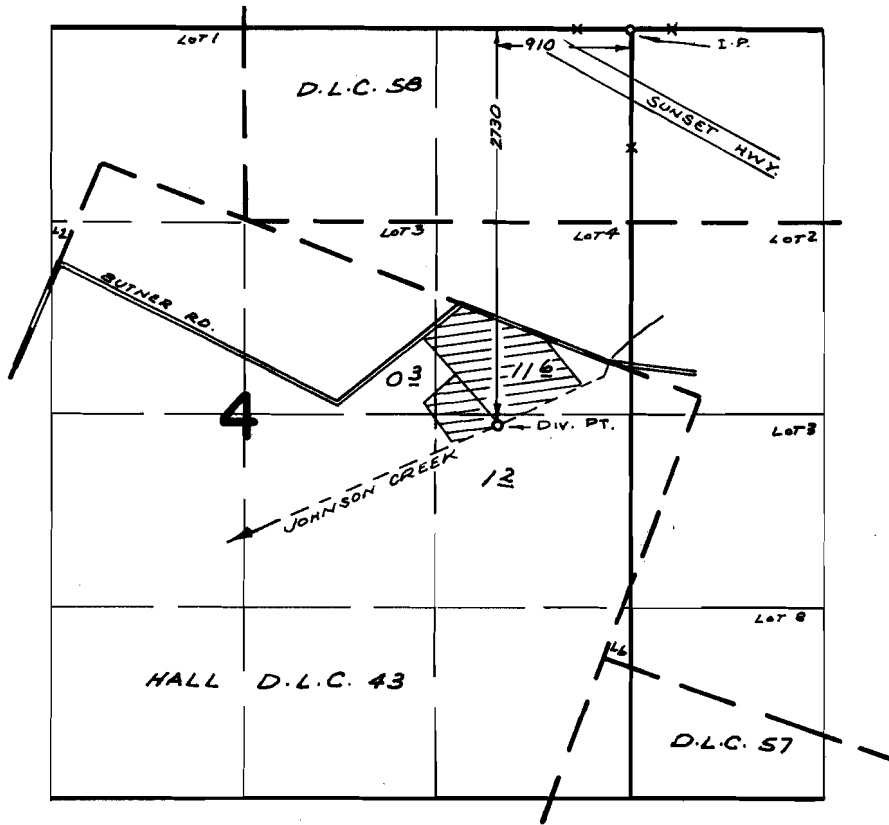

FINAL PROOF SURVEY UNDER

Application No. 43881 Permit No. 32789
IN NAME OF

GROVER J. KILLPACK

Surveyed OCT. 31, 1972, by R. MUCKEN