


# T.I.S.R.I.W.W.M.

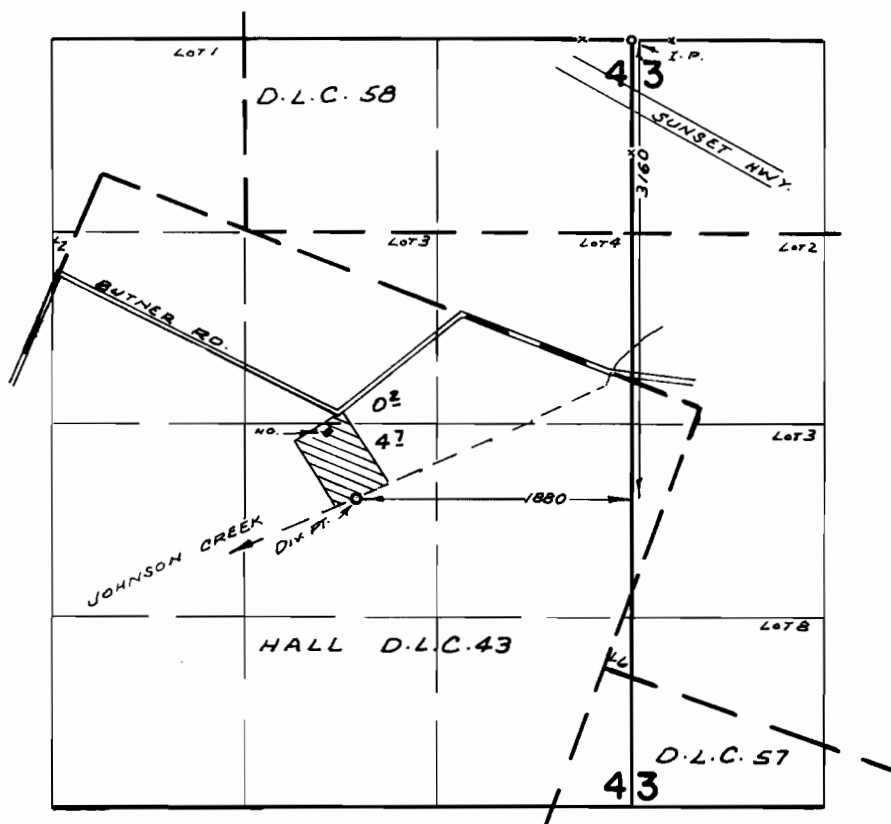

## FINAL PROOF SURVEY UNDER

Application No. 44861 Permit No. 33545  
IN NAME OF

JAMES N. ALLRED

Surveyed OCT. 31, 1972, by R. MUCKEN