


T.2N.R.2W.W.M.

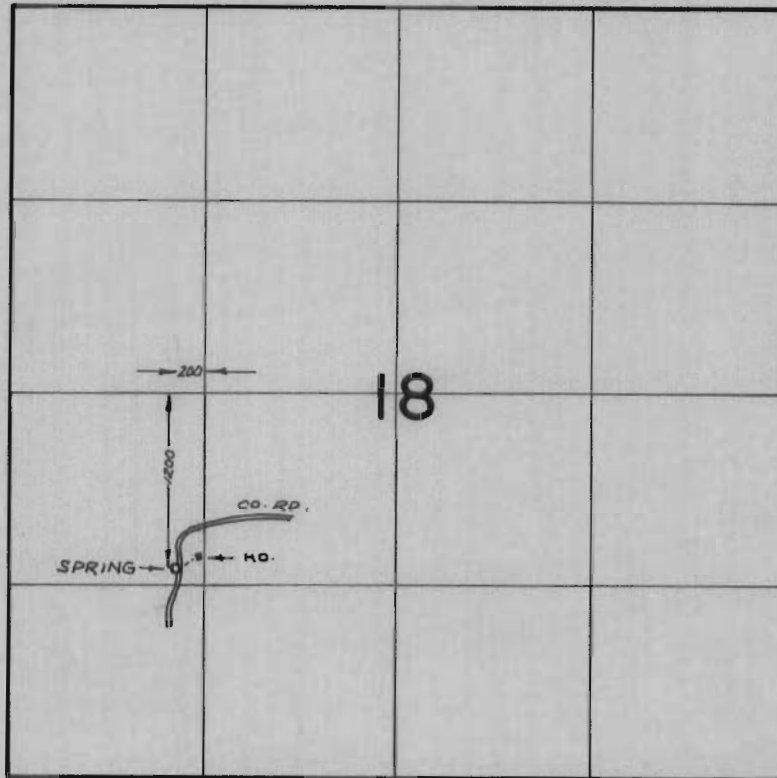

FINAL PROOF SURVEY
UNDER

Application No. 47726 Permit No. 35750
IN NAME OF

JAMES SHAW & NORMA SHAW (H & W)

Surveyed SEPT 18, 1972, by R. MUCKEN