


T. 4S., R. 4W., W.M.

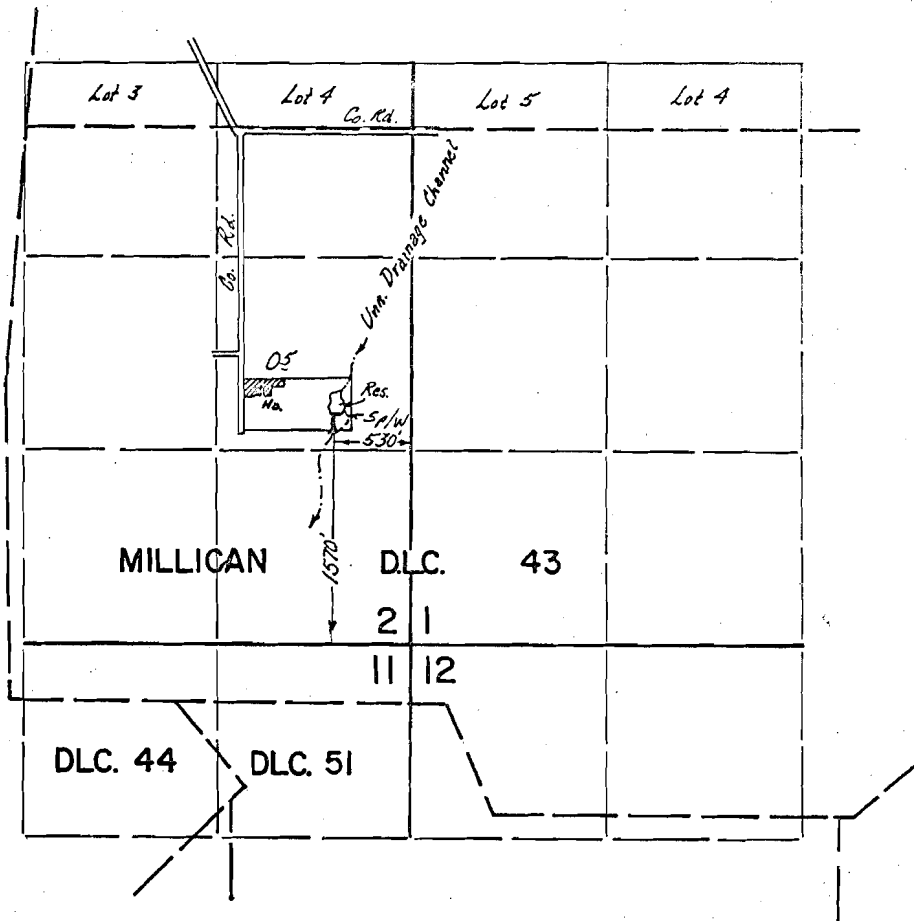

**FINAL PROOF SURVEY**  
UNDER

R-40226                      R-4493  
Application No. 40227    Permit No. 30002  
IN NAME OF

*JOSEPH A. & CAROL LONG*

Surveyed 15 Nov. 1972, by D. NORBY