


T. 4S., R. 4W., W.M.

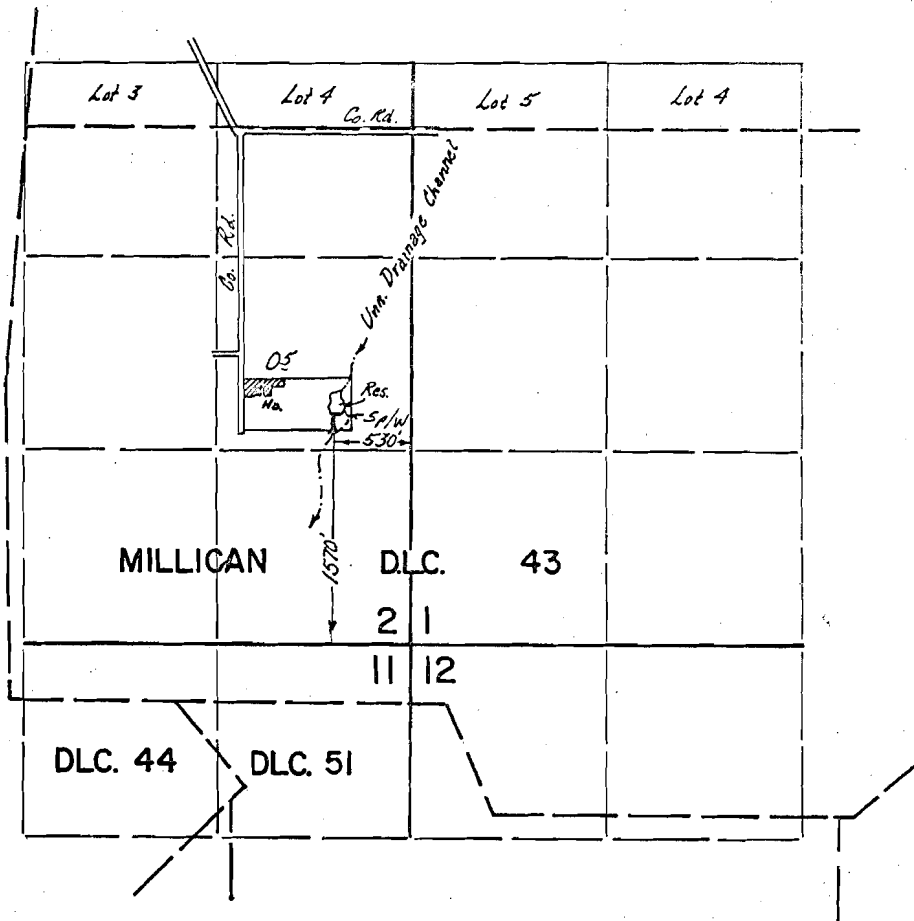

FINAL PROOF SURVEY
UNDER

R-40226 R-4493
Application No. 40227 Permit No. 30002
IN NAME OF

JOSEPH A. & CAROL LONG

Surveyed 15 Nov. 1972, by D. NORBY