


# T. 3S. R. 4W. W.M.

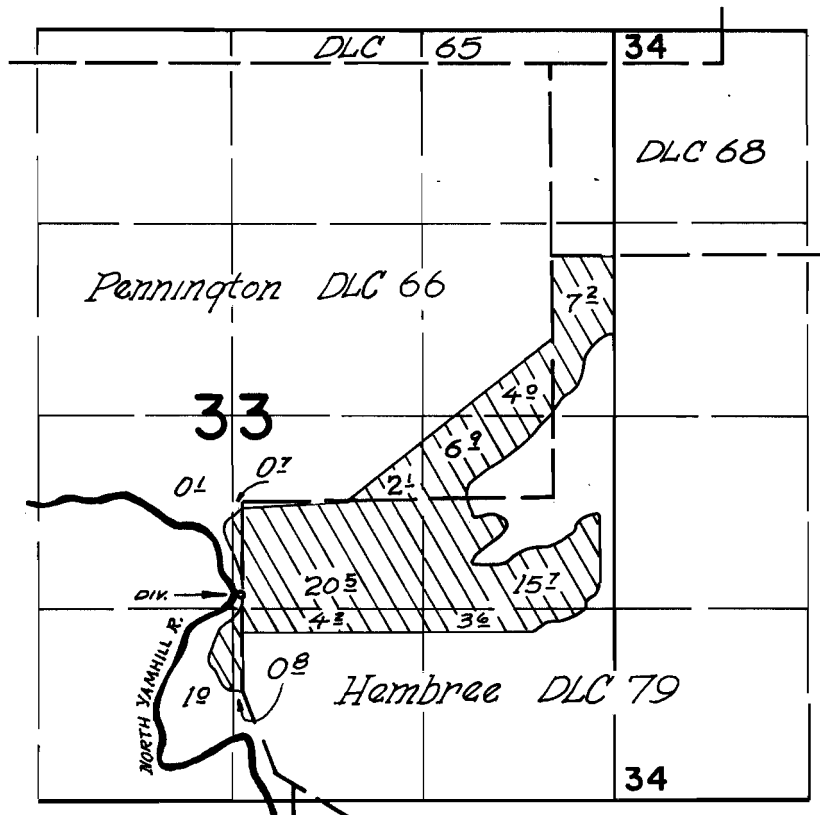

DIV. PT. — 650' S., 20' W. FROM THE MOST WESTERLY N.W. COR.  
OF THE HEMBREE DLC 79

## FINAL PROOF SURVEY UNDER

Application No. 43502 Permit No. 32138  
IN NAME OF

RALPH SCHOOF

Surveyed SEPT 19, 1973, by L. GOULD