


T.15S., R.5 W., W.M.

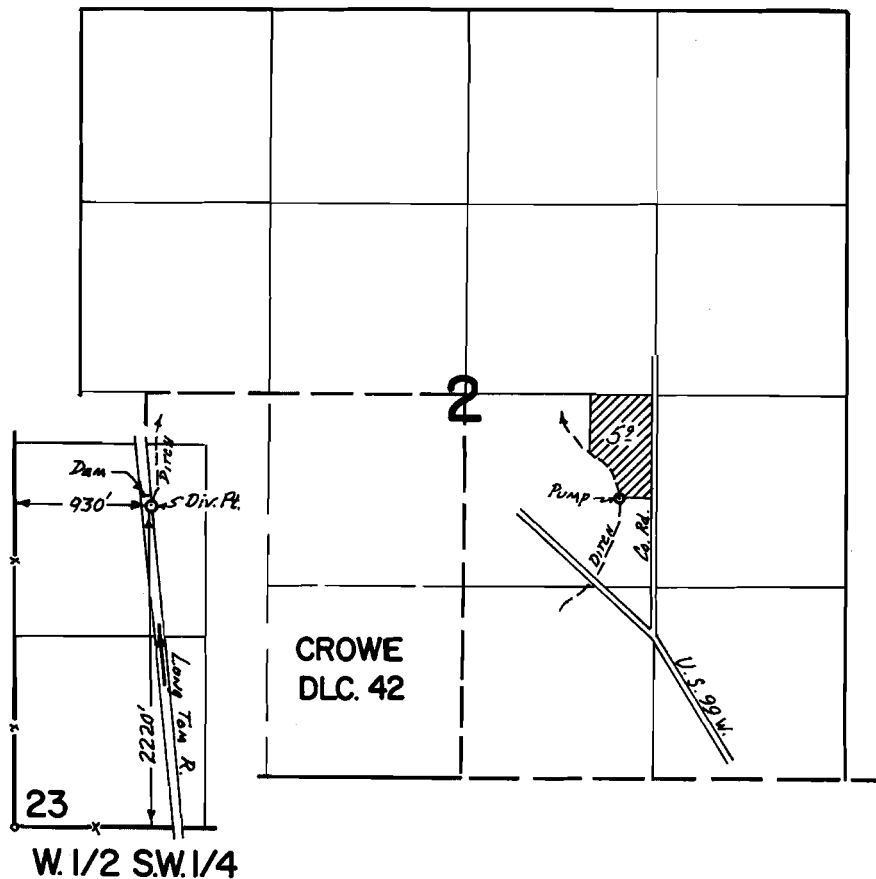

FINAL PROOF SURVEY
UNDER

Application No. 44565 Permit No. 33356
IN NAME OF

JAKE P. & GLADYS I. HENDERSON

Surveyed 26 Sept. 1972, by D. NORBY