


T.5S., R.2E., W.M.

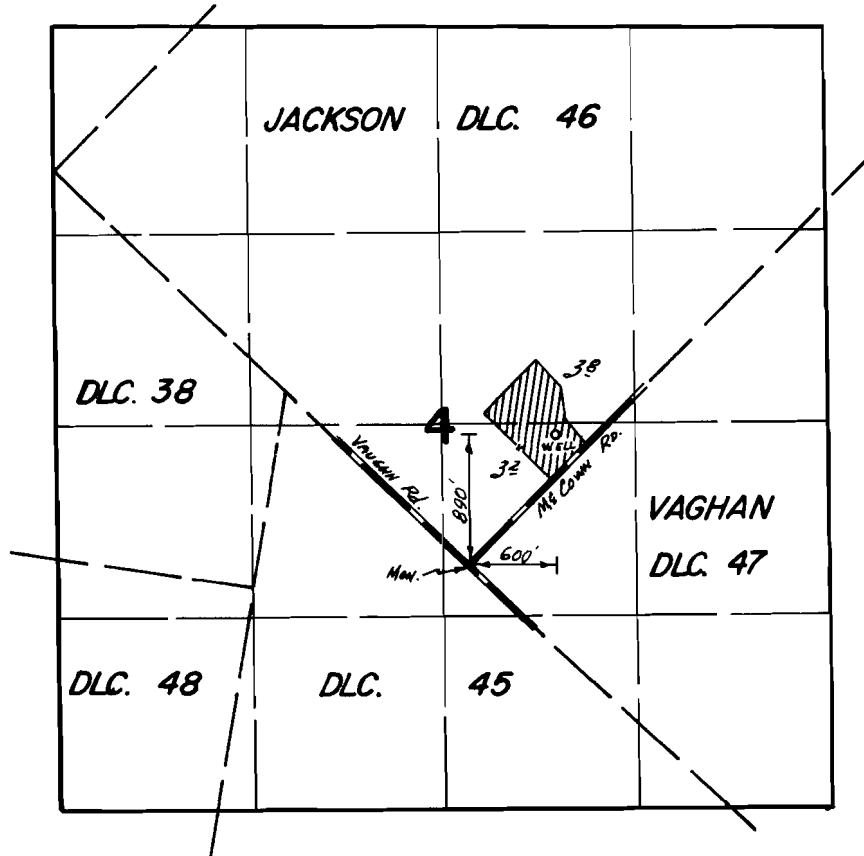

FINAL PROOF SURVEY
UNDER

Application No. G-4170 Permit No. G-3919
IN NAME OF

CHARLES J. &/or ELMA BRONSON

Surveyed July 27 1913, by D. NORSBY