


T. 4S., R. 1E., W. 1M.

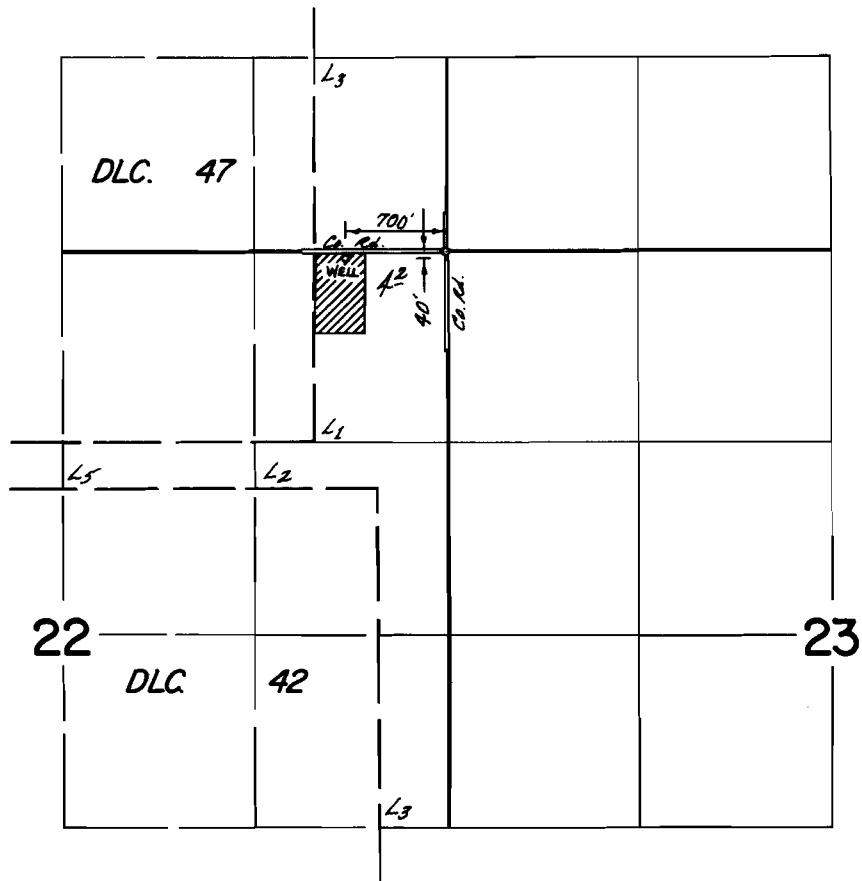

**FINAL PROOF SURVEY**  
UNDER

Application No. G-4266 Permit No. G-4018  
IN NAME OF

CLARENCE POTAMPA

Surveyed July 31 1973, by D. NORBY