


T. 3 S. R. 1 E. W. M.

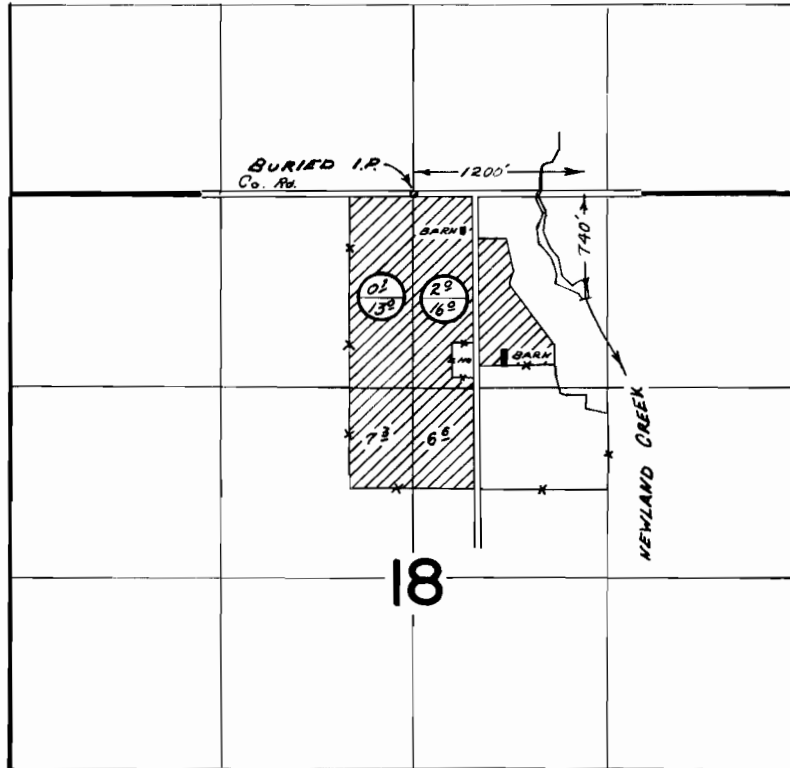

○ PRIMARY
SUPPLEMENTAL

FINAL PROOF SURVEY UNDER

Application No. ⁴³¹⁸⁸_{R-46065} ³²²⁸⁷_{R-5414} Permit No. ₄₆₀₆₆ ₃₄₁₀₀
IN NAME OF

.....WILBUR BRUCK.....

Surveyed SEP. 12, 1972, by R. G. MUSKEN.