


T.2S. R.5E. W.M.

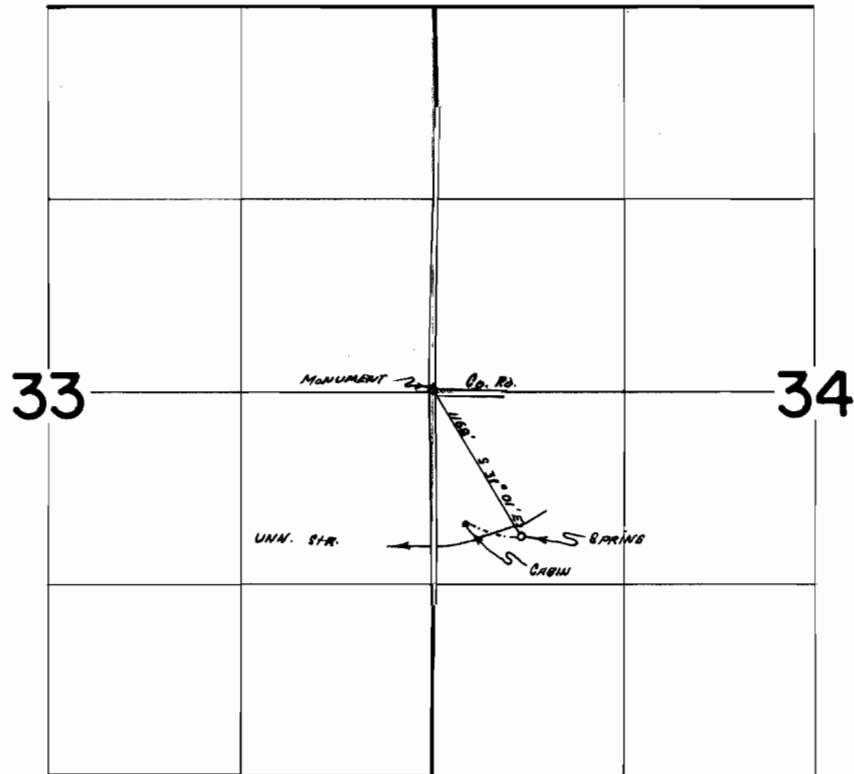

FINAL PROOF SURVEY
UNDER

Application No. 38872 Permit No. 28948
IN NAME OF

MRS. PAULA WYGANT

Surveyed MAY 25 1972, by R. G. MUCKEN