


T.2S. R.3E. W.M.

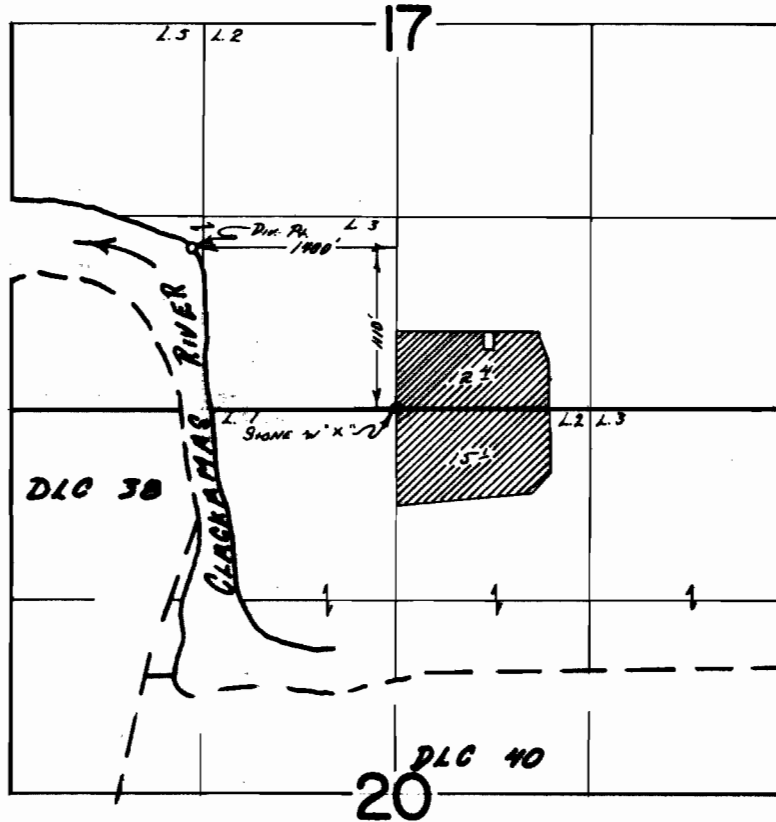

FINAL PROOF SURVEY
UNDER

Application No. 41675 Permit No. 34997
IN NAME OF

WADE NEWBEGIN

Surveyed SEP 14 1977, by R.P. MURKIN