


T.5S.,R.2E.,W.M.

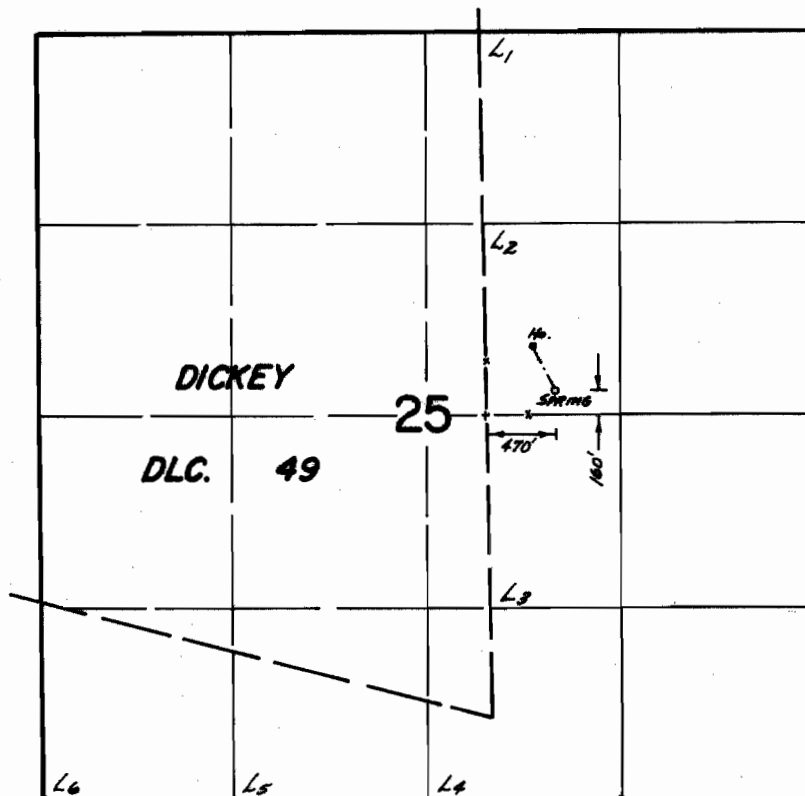

FINAL PROOF SURVEY
UNDER

Application No. 46894 Permit No. 35059
IN NAME OF

JOHN WEYGANDT

Surveyed July 26 1973, by D. NORBY