
T2S. R.3E. W.M.

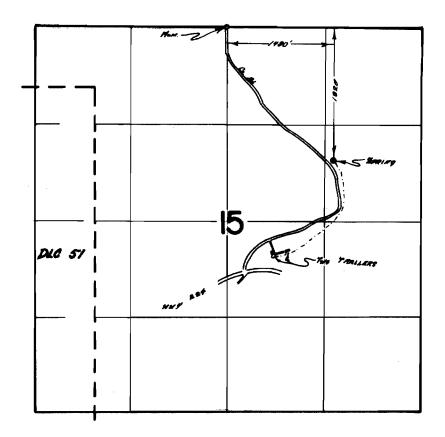

FINAL PROOF SURVEY

PHILLIP H. & RONALD E. DIEDE

Surveyed . Roc. 19.52., by . R. R. Muskati