


T.28&3S. R.5E. W.M.

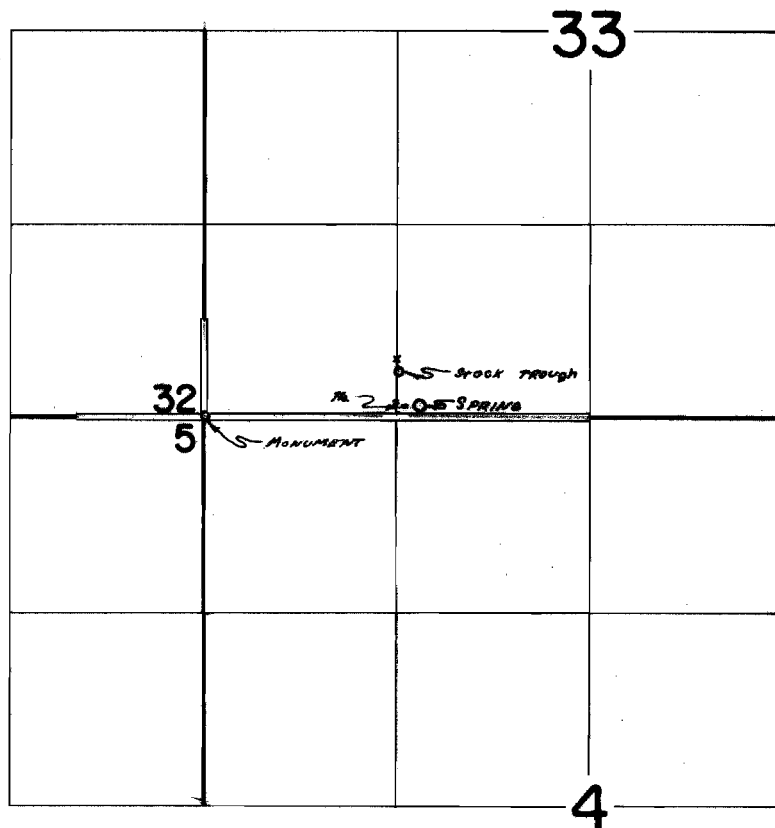

SPRING Loc: 70' N & 1480' E FROM SW Cor. Sec. 33

**FINAL PROOF SURVEY**  
UNDER

Application No. 47406 Permit No. 35567  
IN NAME OF

FRANK L. WOODS

Surveyed MAY 23 1972, by R. B. MUCKEN