


•

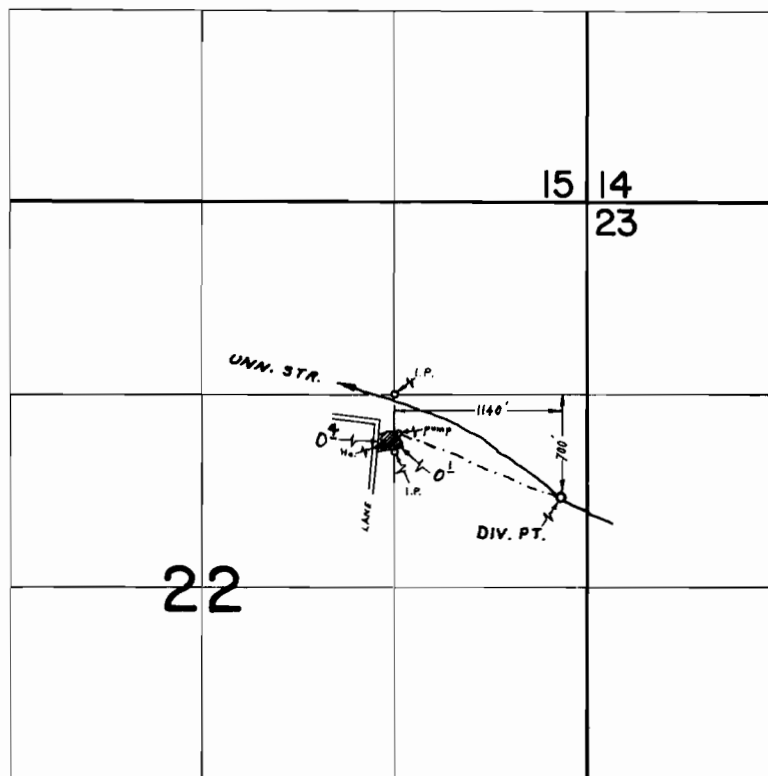

FINAL PROOF SURVEY

UNDER

Application No. 47358 Permit No. 35117
IN NAME OF _____

HENRY C. DESLER

Surveyed APRIL 30, 1973, by R. MUCKEN