


T.28 S.R.14 W.W.M.

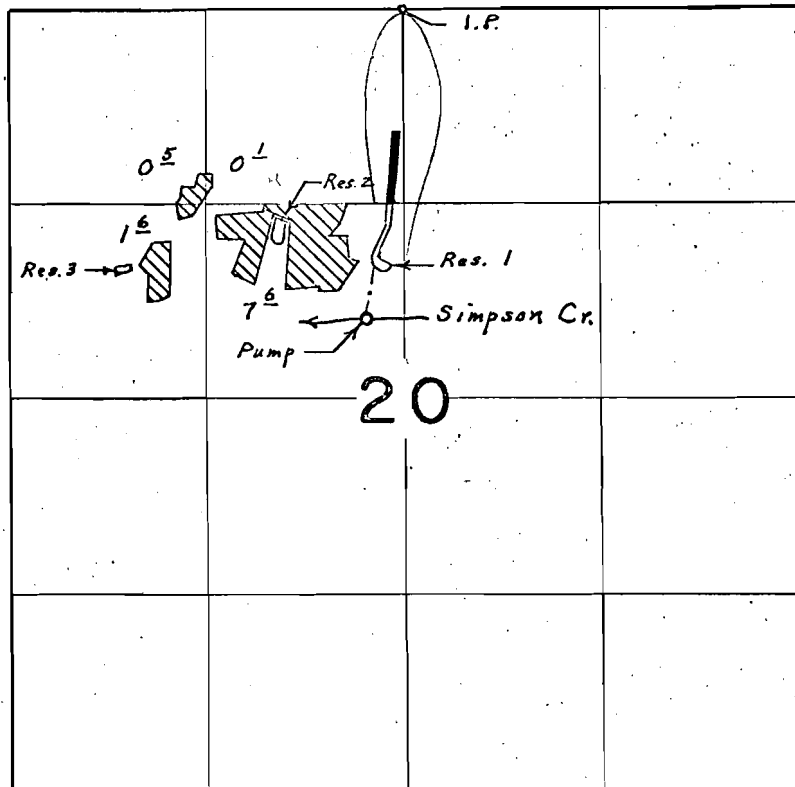

Div. Pts. located: 1730' S. & 150' W.; 1500' S. & 830' W.;
 1740' S. & 1880' W. (all from N. $\frac{1}{4}$ Cor. Sec. 20
 2100' S. & 240' W.)

FINAL PROOF SURVEY UNDER

R-46159 R-5489
 Application No. 46557 Permit No. 34497
 IN NAME OF

PAUL R. & ROSETTA A. KENT

Surveyed April 11, 1972, by L. E. Gould