


T. 25S. R. 6W. W.M.

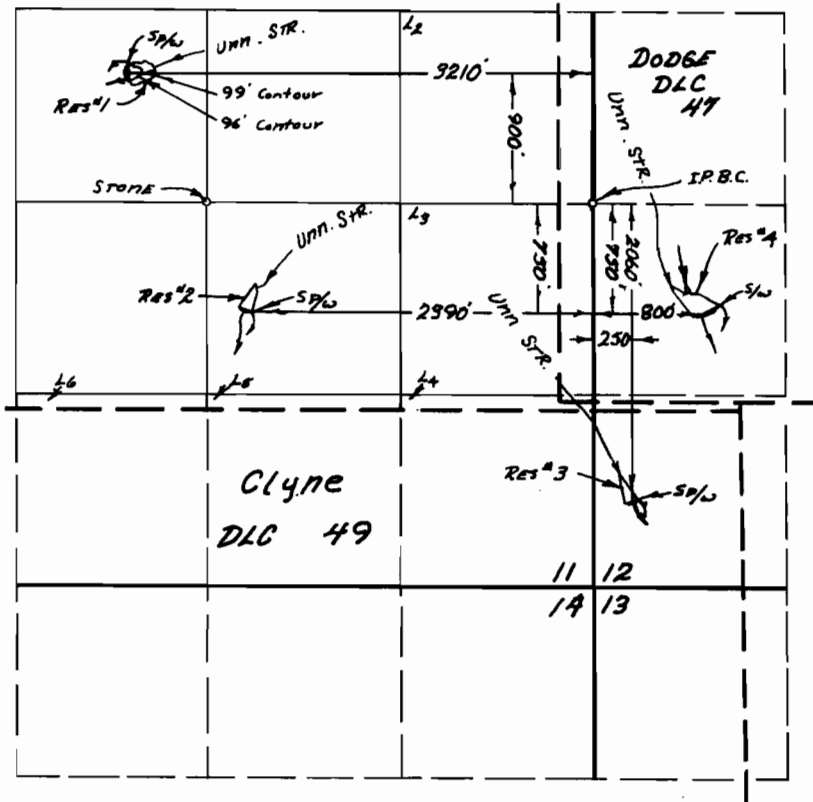

FINAL PROOF SURVEY UNDER

Application No. R-47964 Permit No. R-5772
R-47762 R-5766
 IN NAME OF

ROBERT K. SPLEDY

Surveyed MAY 3 1972, by L. E. GOULD