


T.25S. R.6W. W.M.

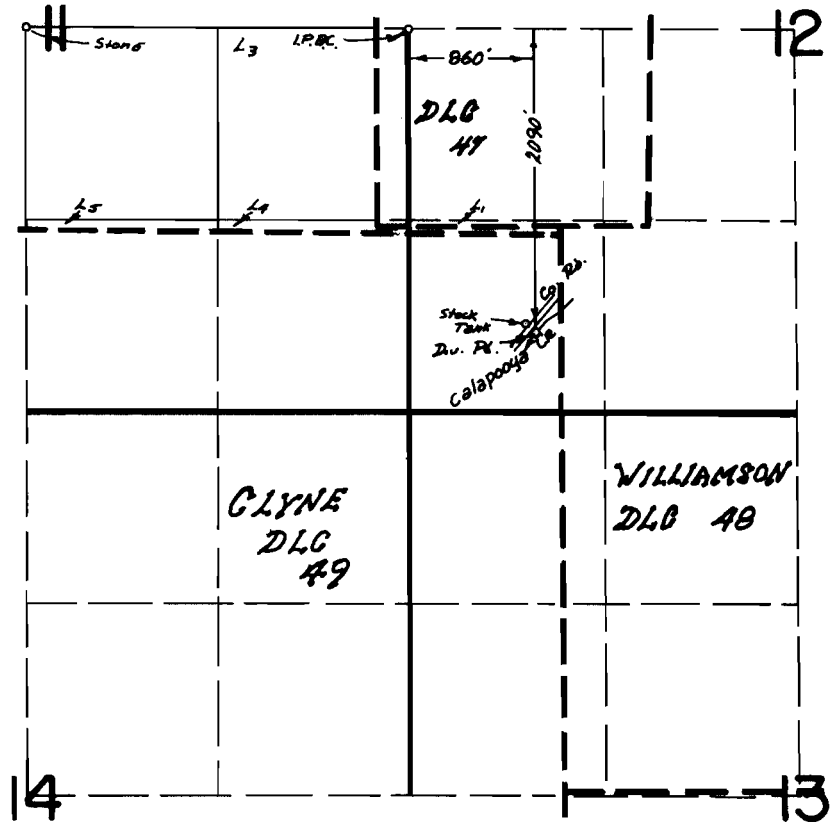

FINAL PROOF SURVEY
UNDER

Application No. 40690 Permit No. 30304
IN NAME OF

Robert K. Speedy

Surveyed May 3 1972, by L. E. Gould