


T.37S., R.12E., W.M.

Muler Ck. & Moe.

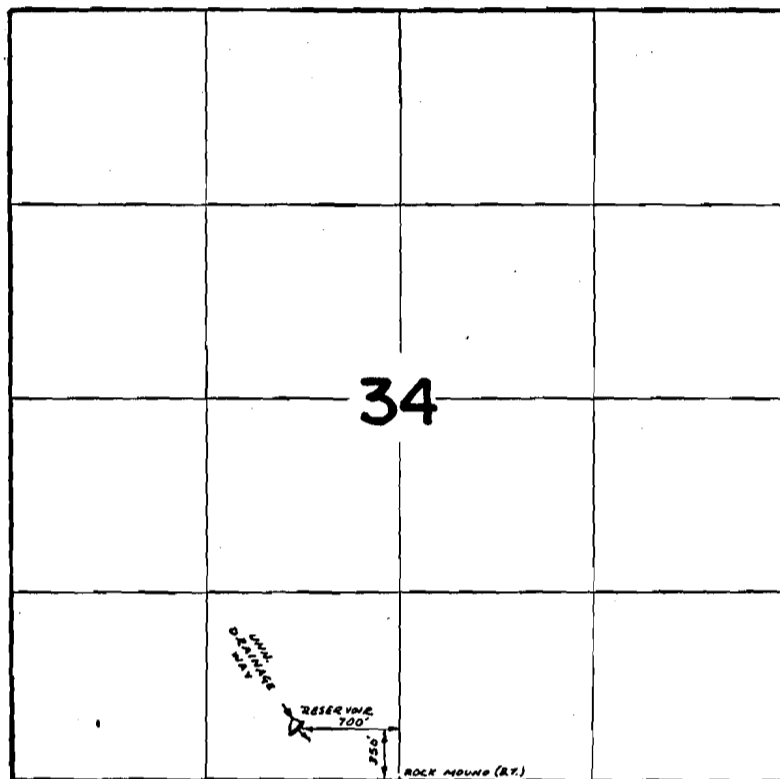

FINAL PROOF SURVEY UNDER

Application No. R-44248 Permit No. R-5110
IN NAME OF

HAROLD E. WILLIAMS

Surveyed Oct. 12 1972, by D. Nerby