


T. 16 S. R. 4 W. W.M.

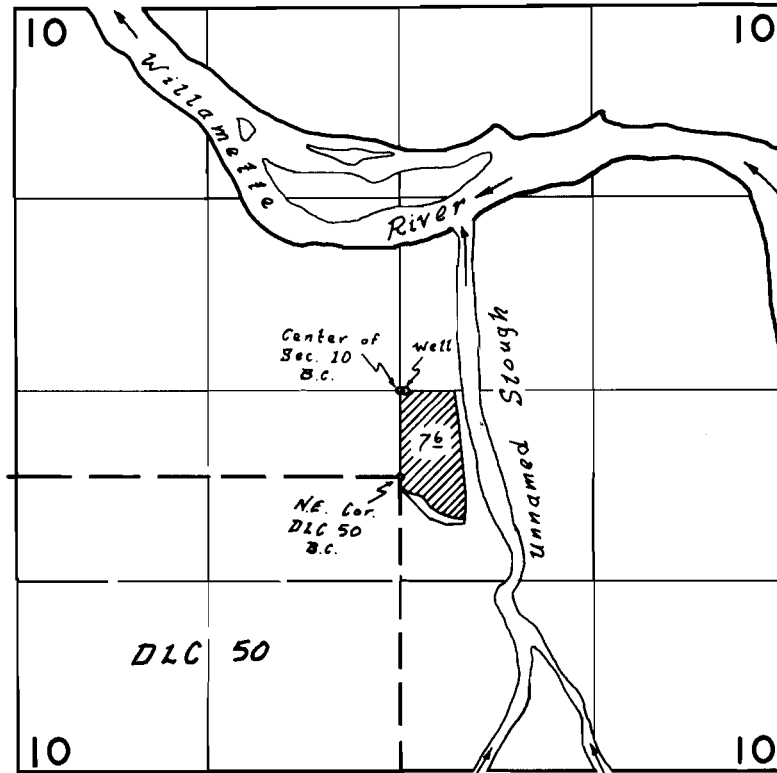

Well loc. 3' S. & 45' E. from Center Sec. 10

**FINAL PROOF SURVEY**  
UNDER

Application No. G-4443 Permit No. G-4189  
IN NAME OF

*L. J. Zumwalt*

Surveyed *6 July* 1972, by *L. E. Gould*