


T.15S., R.4W., W.M.

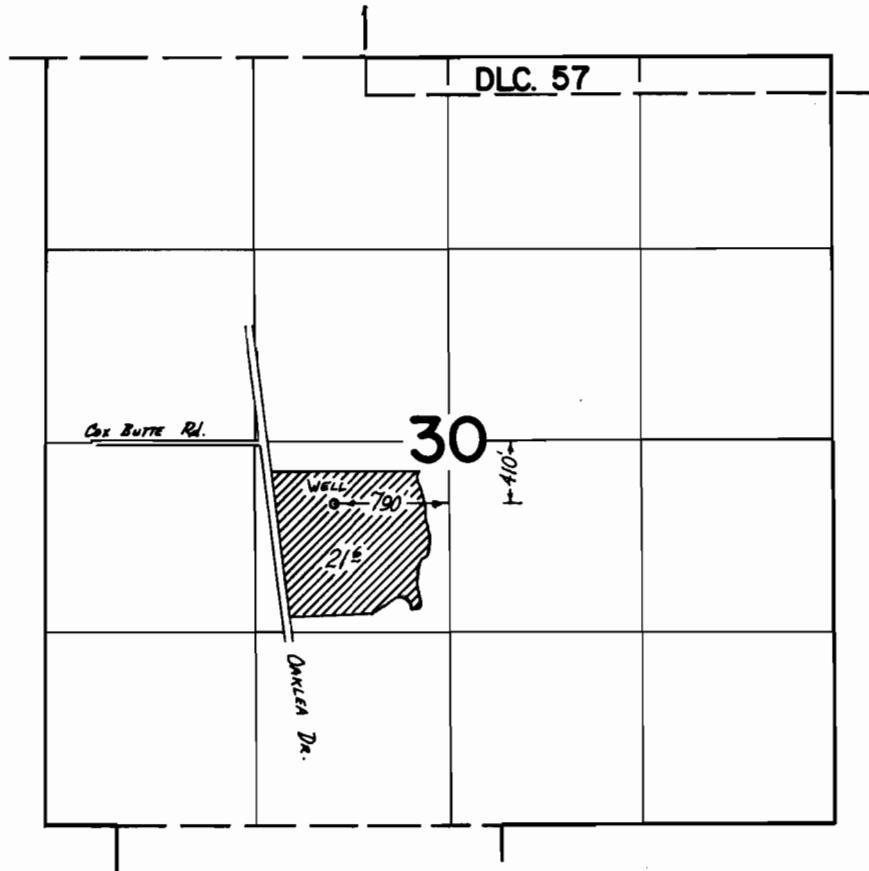

FINAL PROOF SURVEY
UNDER

Application No. G-4766 Permit No. G-4489
IN NAME OF

CLARRY A. OTTOSEN

Surveyed 25 Sept. 1972, by D. NORBY