
T. 20S. R. 3W. W. M.

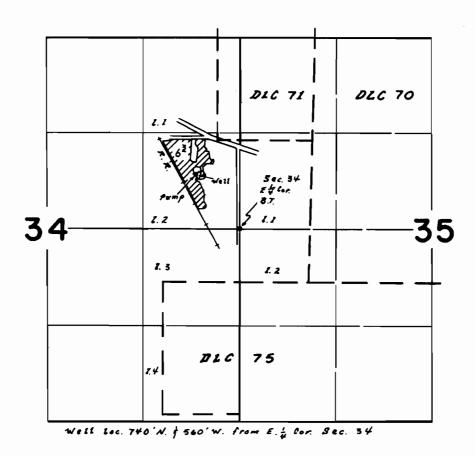

FINAL PROOF SURVEY

Application No. G-4820 Permit No. G-4540
IN NAME OF

Elvin W. Adamson

Surveyed 2 June 1972, by L.E. Gould