


T. 16 S. R. 4 W. W.M.

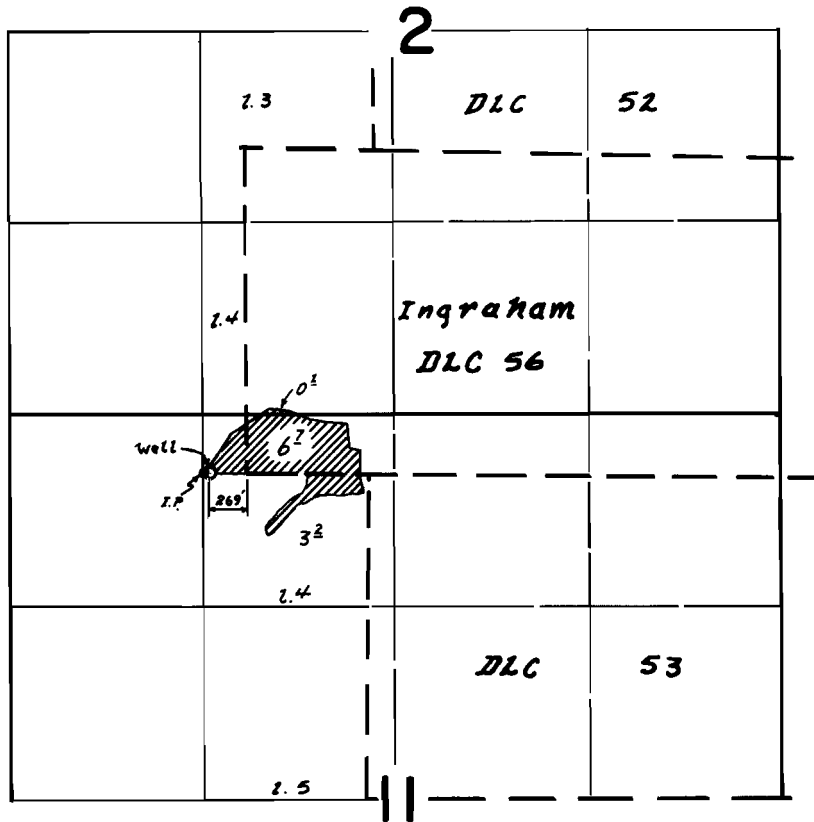

FINAL PROOF SURVEY
UNDER

Application No. G-5105 Permit No. G-4817
IN NAME OF

Wallace Glen Detering

Surveyed 7 July 1972 by L.E. Gould