


T.20S. R.3W. W.M.

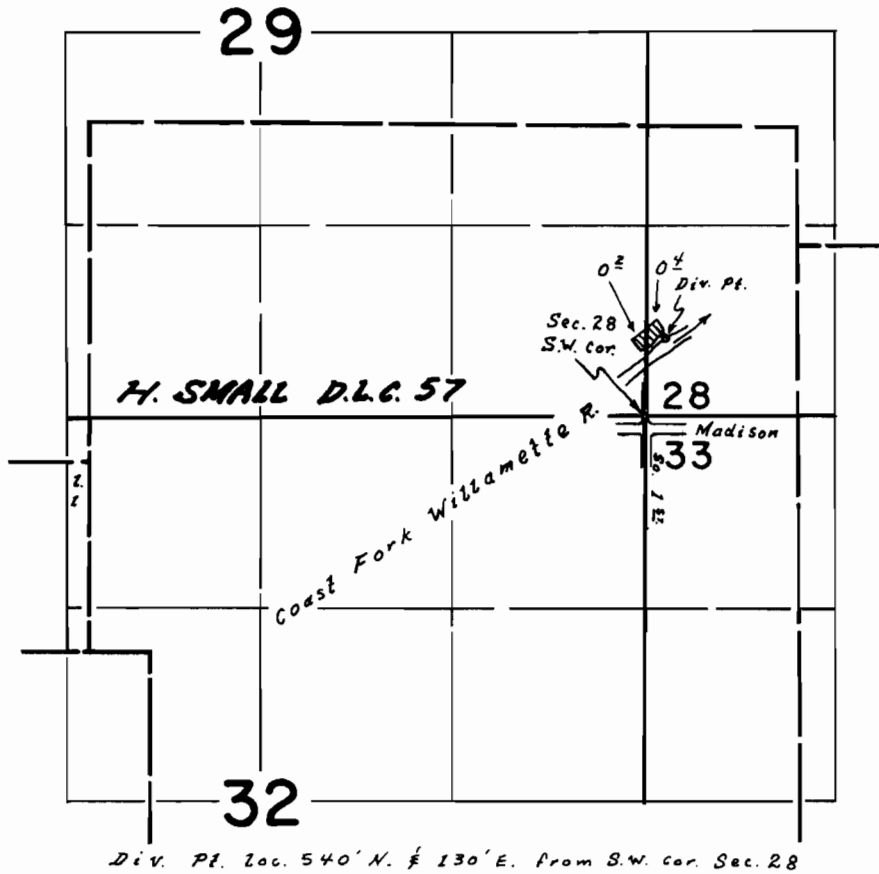

FINAL PROOF SURVEY
UNDER

Application No. 41657 Permit No. 31086
IN NAME OF

James E. & Barbara R. Gant

Surveyed 2 June 1972, by L.E. Gould