


T.17S. R.2W. W.M.

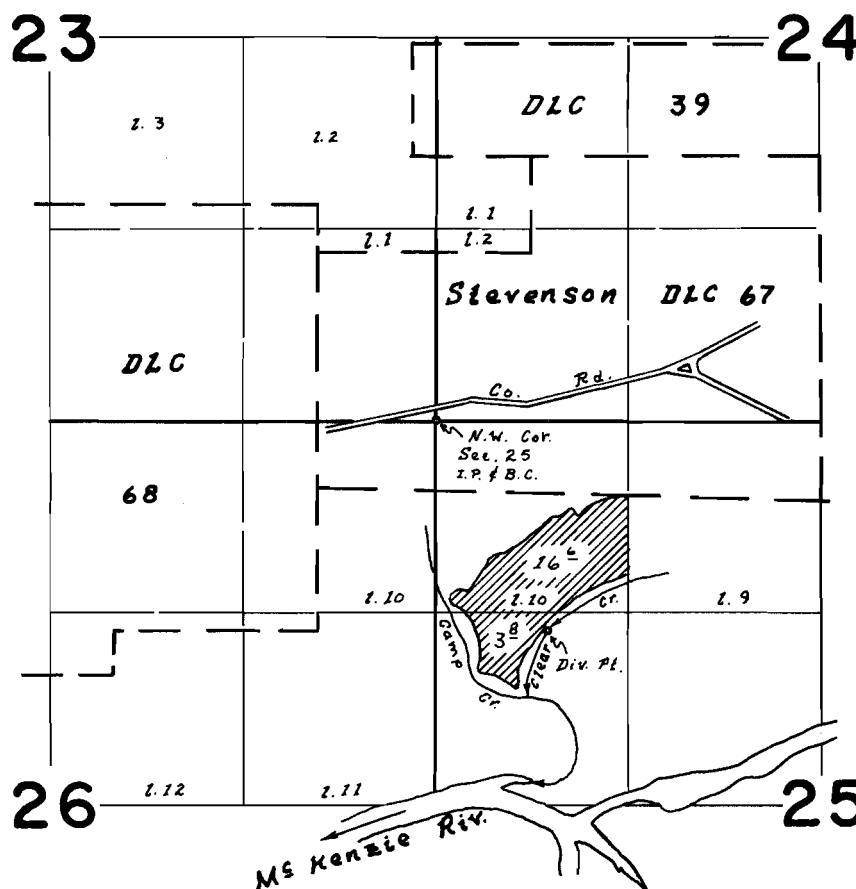

Div. Pl. Loc. 1440'S & 770'E. from N.W. Cor. Sec. 25

FINAL PROOF SURVEY UNDER

Application No. 44211 Permit No. 33027

IN NAME OF

John Edward Whalley, Jr.

Surveyed 27 July 1972, by L.E. Gould