


T.15S., R. 5W., W.M.

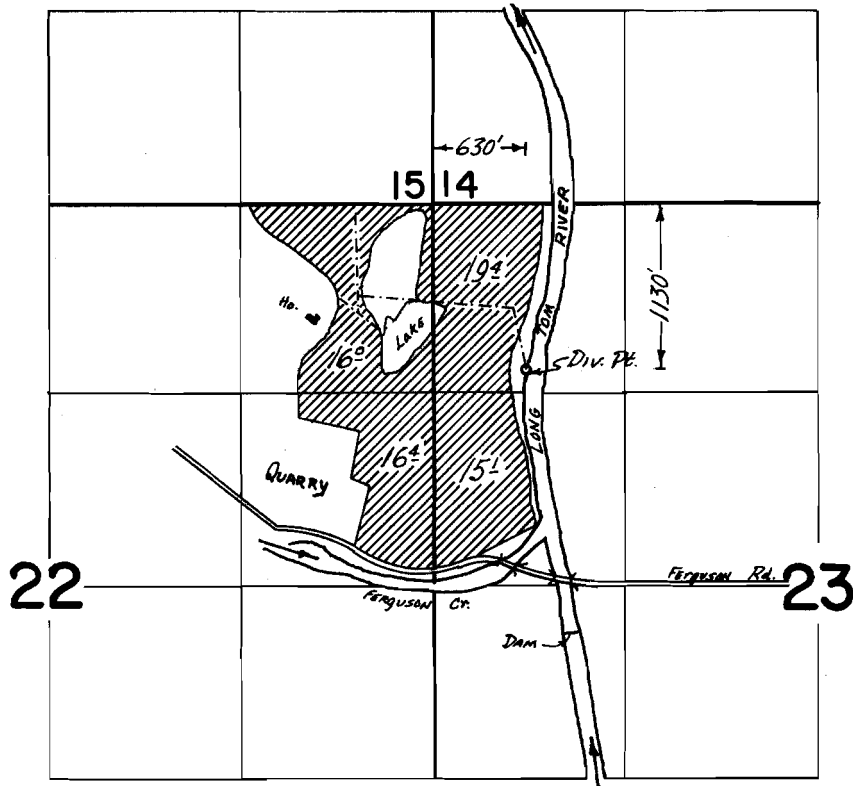

FINAL PROOF SURVEY
UNDER

Application No. 43736 Permit No. 33062
IN NAME OF

JAMES E. & MAE DETERING

Surveyed 26 Sept. 1972, by D. NORBY